

WS

315332

WELL CONSTRUCTION RECORD

WELL CONTRACTOR: Dewey Wright Well Pump Co., Inc
 WELL CONTRACTOR CERTIFICATION #: 2878
 STATE WELL CONSTRUCTION PERMIT#: Steve Price

050387

1. WELL USE (Check Applicable Box): Residential Municipal Industrial Agricultural Monitoring
 Recovery Heat Pump Water Injection Other If Other, List Use: _____

2. WELL LOCATION: (Show sketch of the location below)
 Nearest Town: BOONE County: WATAUGA
PRIVATE DR. OFF MIDDLE RIDGE RD. OFF HWY 194 OF
(Road Name and Numbers, Community, or Subdivision and Lot No.)

3. DRILLING LOG

From	To	DEPTH Formation Description
0	59	DIRT
59	90	GRANITE
90	91	GRANITE
91	170	GRANITE
170	171	GRANITE
171	200	GRANITE
200	201	GRANITE
201	330	GRANITE
330	332	QUARTZ
332	345	GRANITE

4. DATE DRILLED 7/19/2005
 5. TOTAL DEPTH 345
 6. CUTTINGS COLLECTED YES NO
 7. DOES WELL REPLACE EXISTING WELL? YES NO
 8. STATIC WATER LEVEL Below Top of Casing: 50 FT.
(Use "+" if Above Top of Casing)

9. TOP OF CASING IS 1 FT. Above Land Surface*
*Top of casing terminated at/or below land surface requires a variance in accordance with 15A NCAC 2C.0118
 10. YIELD (gpm): 10 METHOD OF TEST Air
 11. WATER ZONES (depth): 1.00 gpm 90-91 1.00 gpm 170-171
1.00 gpm 200-201 7.00 gpm 330-332
 12. CHLORINATION: Type HTH Amount 59
If additional space is needed use back of form

13. CASING:

From	To	Depth	Diameter	Wall Thickness or Weight/Ft.	Material
0	35	Ft.	6 1/8	.350	PVC
35	345	Ft.			

14. GROUT:

From	To	Depth	Material	Method
0	20	Ft.	Cement	Gravity Flow
20	345	Ft.		


15. SCREEN:

From	To	Depth	Diameter	Slot Size	Material
		Ft.	in.	in.	
		Ft.	in.	in.	
		Ft.	in.	in.	

16. SAND/GRAVEL PACK:

From	To	Depth	Size	Material
		Ft.		
		Ft.		

17. REMARKS: _____
 I DO HEREBY CERTIFY THAT THIS WELL WAS CONSTRUCTED IN ACCORDANCE WITH 15A NCAC 2C, WELL CONSTRUCTION STANDARDS, AND THAT A COPY OF THIS RECORD HAS BEEN PROVIDED TO THE WELL OWNER.

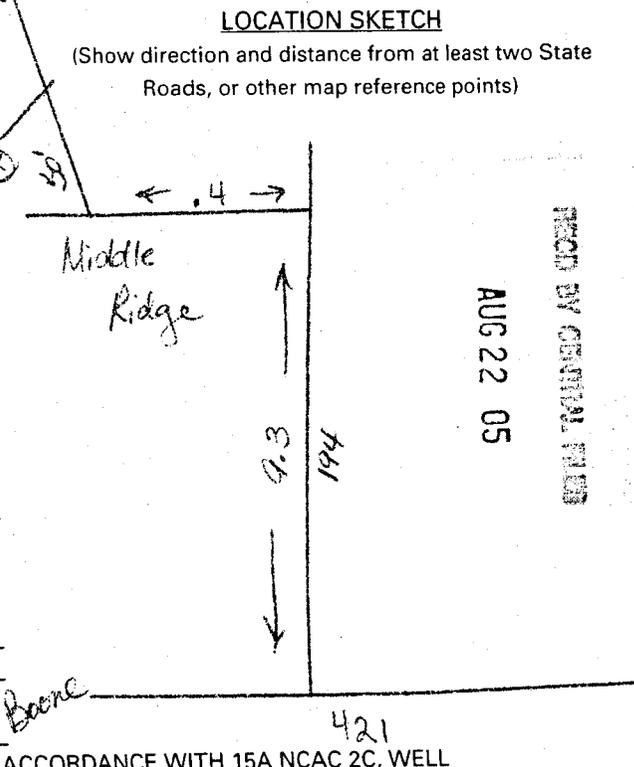

Steve Price
 SIGNATURE OF PERSON CONSTRUCTING THE WELL
 DATE 8-10-05

FOR OFFICE USE ONLY
 Quad No: _____