

WS

315333

WELL CONSTRUCTION RECORD

050361

WELL CONTRACTOR: Dewey Wright Well Pump Co., Inc.
 WELL CONTRACTOR CERTIFICATION #: 2878
 STATE WELL CONSTRUCTION PERMIT#: Steve Price

1. WELL USE (Check Applicable Box): Residential Municipal Industrial Agricultural Monitoring
 Recovery Heat Pump Water Injection Other If Other, List Use: _____

2. WELL LOCATION: (Show sketch of the location below)
 Nearest Town: BOONE County: WATAUGA
PRIVATE DR. OFF DOGWOOD KNOLL OFF CORBETT M
(Road Name and Numbers, Community, or Subdivision and Lot No.)

3. DATE DRILLED 7/21/2005
 4. TOTAL DEPTH 505
 5. CUTTINGS COLLECTED YES NO
 6. DOES WELL REPLACE EXISTING WELL? YES NO
 7. STATIC WATER LEVEL Below Top of Casing: 200 FT.
(Use "+" if Above Top of Casing)

DRILLING LOG		DEPTH
From	To	Formation Description
0	34	DIRT
34	335	GRANITE
335	337	QUARTZ
337	460	GRANITE
460	481	QUARTZ
481	505	GRANITE

TOP OF CASING SET
AUG 22 2005


If additional space is needed use back of form

9. TOP OF CASING IS 1 FT. Above Land Surface*
*Top of casing terminated at/or below land surface requires a variance in accordance with 15A NCAC 2C.0118
 10. YIELD (gpm): 20 METHOD OF TEST Air
 11. WATER ZONES (depth): 10.00 gpm 335-337 10.00 gpm 460-481
0.00 gpm 0.00 gpm
 12. CHLORINATION: Type HTH Amount 64

13. CASING:

From	Depth	To	Diameter	Wall Thickness or Weight/Ft.	Material
0	0	40	6 1/8	350	PVC
40	40	505			

LOCATION SKETCH
 (Show direction and distance from at least two State Roads, or other map reference points)

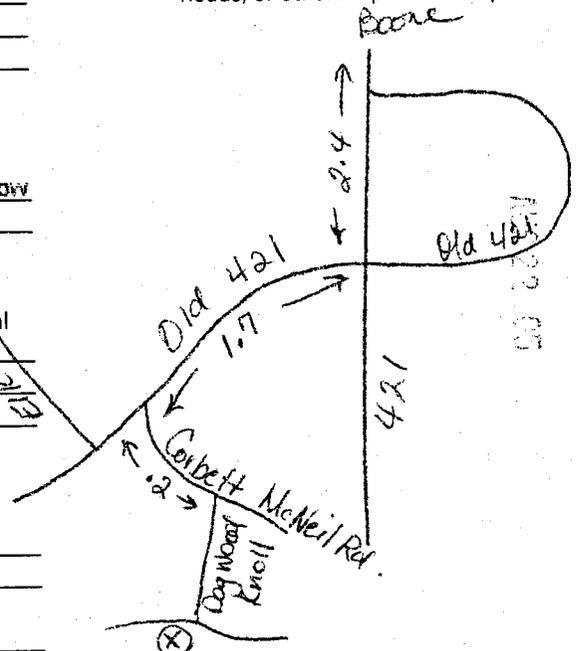

14. GROUT:

From	Depth	To	Material	Method
0	0	20	Cement	Gravity Flow

15. SCREEN:

From	Depth	To	Diameter	Slot Size	Material

16. SAND/GRAVEL PACK:

From	Depth	To	Size	Material

17. REMARKS: _____
 I DO HEREBY CERTIFY THAT THIS WELL WAS CONSTRUCTED IN ACCORDANCE WITH 15A NCAC 2C, WELL CONSTRUCTION STANDARDS, AND THAT A COPY OF THIS RECORD HAS BEEN PROVIDED TO THE WELL OWNER.

Steven Price

8-10-05

FOR OFFICE USE ONLY
 Quad No: _____