

WS
 315337

WELL CONSTRUCTION RECORD

WELL CONTRACTOR: Dewey Wright Well Pump Co., Inc.
 WELL CONTRACTOR CERTIFICATION #: 2878
 STATE WELL CONSTRUCTION PERMIT#: Steve Price

050254

1. WELL USE (Check Applicable Box): Residential Municipal Industrial Agricultural Monitoring
 Recovery Heat Pump Water Injection Other If Other, List Use: _____

2. WELL LOCATION: (Show sketch of the location below)
 Nearest Town: BOONE County: WATAUGA
OLD TURNPIKE OFF SHULL MILL RD. OFF POPLAR GR
(Road Name and Numbers, Community, or Subdivision and Lot No.)

3. DATE DRILLED 6/21/2005
 4. TOTAL DEPTH 165
 5. CUTTINGS COLLECTED YES NO
 6. DOES WELL REPLACE EXISTING WELL? YES NO
 7. STATIC WATER LEVEL Below Top of Casing: 20 FT.
(Use "+" if Above Top of Casing)

DRILLING LOG		DEPTH
From	To	Formation Description
0	84	DIRT
84	115	GRANITE
115	116	QUARTZ
116	155	GRANITE
155	157	QUARTZ
157	165	GRANITE

AUG 22 10 51 AM '05
 TEST BY ORIGINAL FIELD

9. TOP OF CASING IS 1 FT. Above Land Surface*
*Top of casing terminated at/or below land surface requires a variance in accordance with 15A NCAC 2C.0118
 10. YIELD (gpm): 20 METHOD OF TEST Air
 11. WATER ZONES (depth): 2.00 gpm 115-116 18.00 gpm 155-157
0.00 gpm 0.00 gpm
 12. CHLORINATION: Type HTH Amount 30


13. CASING:
 From 0 To 80 Ft. Depth 6 1/8 Diameter 350 Wall Thickness or Weight/Ft. PVC Material

14. GROUT:
 From 0 To 20 Ft. Depth Cement Material Gravity Flow Method

15. SCREEN:
 From _____ To _____ Ft. Depth _____ Diameter _____ Slot Size _____ Material

16. SAND/GRAVEL PACK:
 From _____ To _____ Ft. Depth _____ Size _____ Material

17. REMARKS:

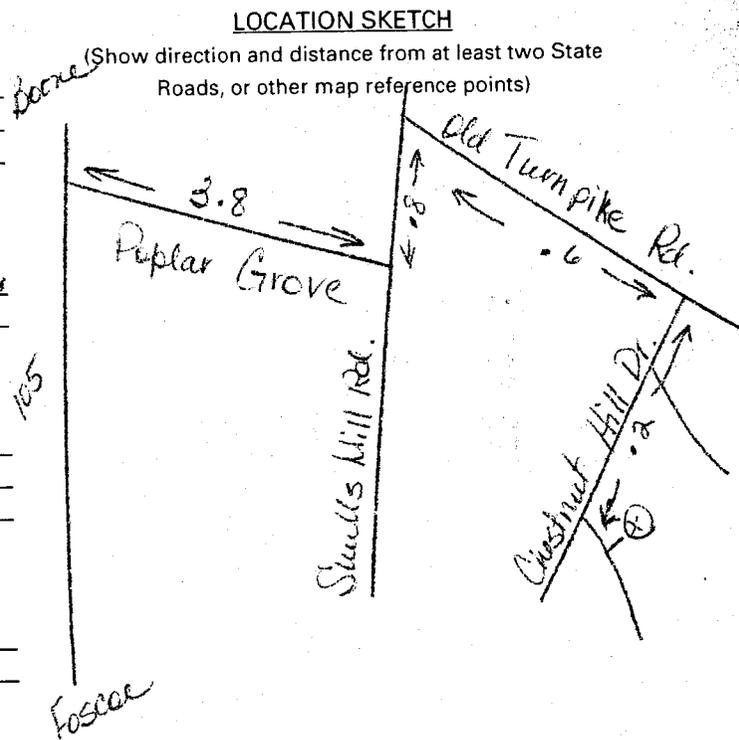

I DO HEREBY CERTIFY THAT THIS WELL WAS CONSTRUCTED IN ACCORDANCE WITH 15A NCAC 2C, WELL CONSTRUCTION STANDARDS, AND THAT A COPY OF THIS RECORD HAS BEEN PROVIDED TO THE WELL OWNER.

Steven Price

8-10-05

SIGNATURE OF PERSON CONSTRUCTING THE WELL
 Submit original to Division of Water Quality, Groundwater Section within 30 days

DATE
 GW-1 REV. 12/99

FOR OFFICE USE ONLY
 Quad No: _____
 Serial No: _____