

WS

315341

**WELL CONSTRUCTION RECORD**

050250

WELL CONTRACTOR: Dewey Wright Well Pump Co., Inc.  
 WELL CONTRACTOR CERTIFICATION #: 2878  
 STATE WELL CONSTRUCTION PERMIT#: Steve Price

1. WELL USE (Check Applicable Box): Residential  Municipal  Industrial  Agricultural  Monitoring   
 Recovery  Heat Pump Water Injection  Other  If Other, List Use: \_\_\_\_\_

2. WELL LOCATION: (Show sketch of the location below)  
 Nearest Town: DEEP GAP County: WATAUGA  
BIG HILL RD. OFF 194 OFF 421  
(Road Name and Numbers, Community, or Subdivision and Lot No.)

3. DATE DRILLED 7/1/2005  
 4. TOTAL DEPTH 145  
 5. CUTTINGS COLLECTED YES  NO   
 6. DOES WELL REPLACE EXISTING WELL? YES  NO   
 7. STATIC WATER LEVEL Below Top of Casing: 10 FT.  
(Use "+" if Above Top of Casing)

DRILLING LOG		DEPTH
From	To	Formation Description
0	30	MUD
30	70	GRANITE
70	71	GRANITE
71	130	GRANITE
130	131	QUARTZ
131	145	GRANITE

FROM ORIGINAL HTH AUG 22 2005


9. TOP OF CASING IS 1 FT. Above Land Surface\*  
\*Top of casing terminated at/or below land surface requires a variance in accordance with 15A NCAC 2C.0118  
 10. YIELD (gpm): 10 METHOD OF TEST Air  
 11. WATER ZONES (depth): 2.00 gpm 70-71 8.00 gpm 130-131  
0.00 gpm 0.00 gpm  
 12. CHLORINATION: Type HTH Amount 27

If additional space is needed use back of form

13. CASING:  

From <u>0</u>	To <u>35</u> Ft.	Depth	Diameter <u>6 1/8</u>	Wall Thickness or Weight/Ft. <u>.350</u>	Material <u>PVC</u>
From _____	To _____	Ft.	_____	_____	_____
From _____	To _____	Ft.	_____	_____	_____

LOCATION SKETCH  
 (Show direction and distance from at least two State Roads, or other map reference points)

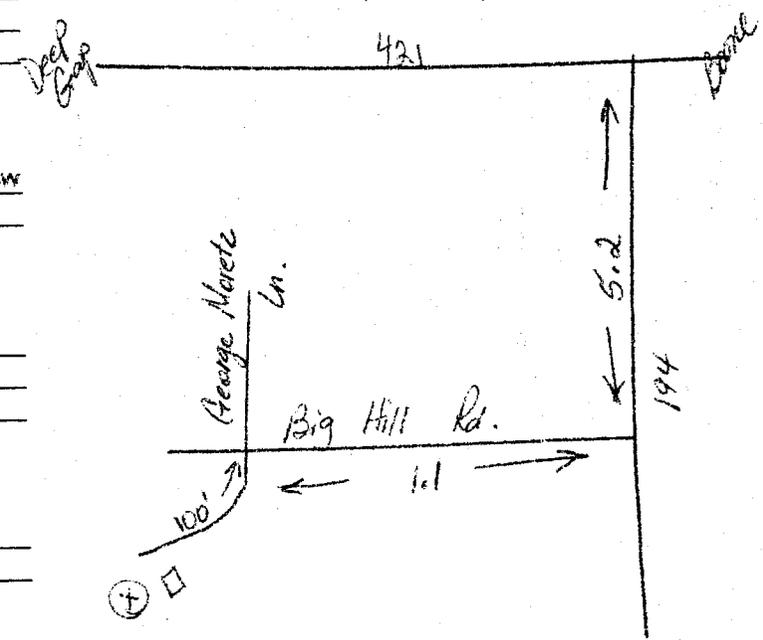

14. GROUT:  

From <u>0</u>	To <u>20</u> Ft.	Depth	Material <u>Cement</u>	Method <u>Gravity Flow</u>
From _____	To _____	Ft.	_____	_____

15. SCREEN:  

From _____	To _____	Depth	Diameter _____	Slot Size _____	Material _____
From _____	To _____	Ft.	_____	_____	_____
From _____	To _____	Ft.	_____	_____	_____

16. SAND/GRAVEL PACK:  

From _____	To _____	Depth	Size _____	Material _____
From _____	To _____	Ft.	_____	_____

17. REMARKS: \_\_\_\_\_

I DO HEREBY CERTIFY THAT THIS WELL WAS CONSTRUCTED IN ACCORDANCE WITH 15A NCAC 2C, WELL CONSTRUCTION STANDARDS, AND THAT A COPY OF THIS RECORD HAS BEEN PROVIDED TO THE WELL OWNER.

*Steve Price*

8-10-05

FOR OFFICE USE ONLY  
 Quad No: \_\_\_\_\_

SIGNATURE OF PERSON CONSTRUCTING THE WELL  
 Submit original to Division of Water Quality, Groundwater Section within 30 days

DATE  
 GW-1 REV. 12/99