

WS

315357

WELL CONSTRUCTION RECORD

050282

WELL CONTRACTOR: Dewey Wright Well Pump Co., Inc.
 WELL CONTRACTOR CERTIFICATION #: 2886
 STATE WELL CONSTRUCTION PERMIT#: Leslie Reece

1. WELL USE (Check Applicable Box): Residential Municipal Industrial Agricultural Monitoring
 Recovery Heat Pump Water Injection Other If Other, List Use: _____

2. WELL LOCATION: (Show sketch of the location below)
 Nearest Town: BOONE County: WATAUGA
PRIVATE DR OFF STUART WILLIAMS OFF N PINE RUN
(Road Name and Numbers, Community, or Subdivision and Lot No.)

3.
 4. DATE DRILLED 8/15/2005
 5. TOTAL DEPTH 380
 6. CUTTINGS COLLECTED YES NO
 7. DOES WELL REPLACE EXISTING WELL? YES NO
 8. STATIC WATER LEVEL Below Top of Casing: 20 FT.
(Use "+" if Above Top of Casing)
 9. TOP OF CASING IS 1 FT. Above Land Surface*
*Top of casing terminated at/or below land surface requires a variance in accordance with 15A NCAC 2C.0118
 10. YIELD (gpm): 2.5 METHOD OF TEST Air
 11. WATER ZONES (depth): 2.50 gpm 324-322 0.00 gpm
0.00 gpm 0.00 gpm
 12. CHLORINATION: Type HTH Amount 69

DRILLING LOG		DEPTH
From	To	Formation Description
0	50	DIRT
50	324	GRANITE
324	322	SHALE
322	380	GRANITE
If additional space is needed use back of form		

DRILLED BY CENTRAL PIER
 AUG 22 2005 10:11 AM

13. CASING:

From	To	Depth	Diameter	Wall Thickness or Weight/Ft.	Material
0	59	Ft.	6 1/8	350	PVC
From	To	Depth	Diameter	Wall Thickness or Weight/Ft.	Material
From	To	Depth	Diameter	Wall Thickness or Weight/Ft.	Material

14. GROUT:

From	To	Depth	Material	Method
0	20	Ft.	Cement	Gravity Flow
From	To	Depth	Material <td>Method</td>	Method

15. SCREEN:


From	To	Depth	Diameter	Slot Size	Material
From	To	Depth	Diameter	Slot Size	Material
From	To	Depth	Diameter	Slot Size	Material

16. SAND/GRAVEL PACK:

From	To	Depth	Size	Material
From	To	Depth <td>Size <td>Material</td> </td>	Size <td>Material</td>	Material
From	To	Depth <td>Size <td>Material</td> </td>	Size <td>Material</td>	Material

17. REMARKS: _____

LOCATION SKETCH
 (Show direction and distance from at least two State Roads, or other map reference points)

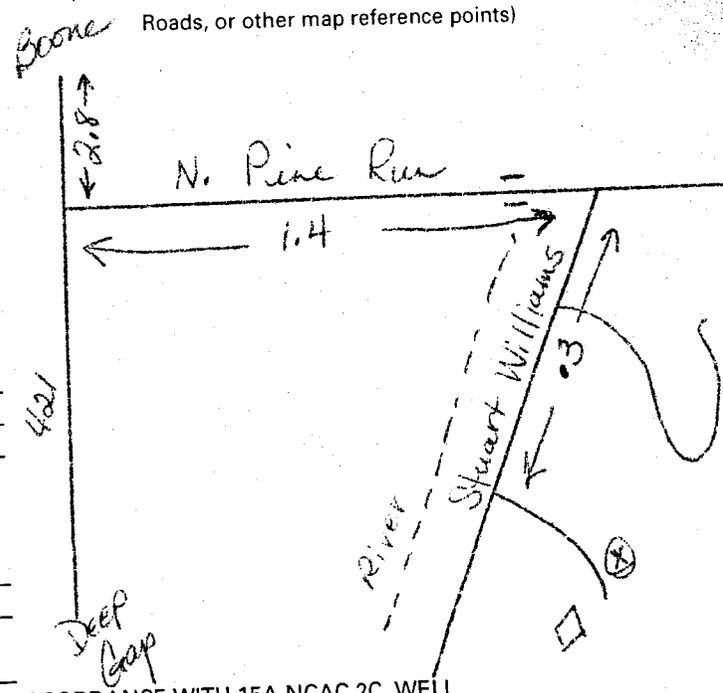

I DO HEREBY CERTIFY THAT THIS WELL WAS CONSTRUCTED IN ACCORDANCE WITH 15A NCAC 2C, WELL CONSTRUCTION STANDARDS, AND THAT A COPY OF THIS RECORD HAS BEEN PROVIDED TO THE WELL OWNER.

Wayne Reece

8-11-05

FOR OFFICE USE ONLY
 Quad No: _____