

WS

316249

**WELL CONSTRUCTION RECORD**

WELL CONTRACTOR: Dawey Wright Well Pump Co., Inc  
 WELL CONTRACTOR CERTIFICATION #: 2681  
 STATE WELL CONSTRUCTION PERMIT#: Steve Pety

050412

1. WELL USE (Check Applicable Box): Residential  Municipal  Industrial  Agricultural  Monitoring   
 Recovery  Heat Pump Water Injection  Other  If Other, List Use: \_\_\_\_\_

2. WELL LOCATION: (Show sketch of the location below)  
 Nearest Town: BLOWING ROCK County: WATAUGA  
SAMPSON RD. OFF PARKWAY OFF AHO RD. OFF 321  
(Road Name and Numbers, Community, or Subdivision and Lot No.)

DRILLING LOG		DEPTH
From	To	Formation Description
0	85	GRAVEL
85	120	GRANITE
120	121	SHALE
121	150	GRANITE
150	152	SHALE
152	165	GRANITE

SEP 16 05

4. DATE DRILLED 8/11/2005  
 5. TOTAL DEPTH 165  
 6. CUTTINGS COLLECTED YES  NO   
 7. DOES WELL REPLACE EXISTING WELL? YES  NO   
 8. STATIC WATER LEVEL Below Top of Casing: 10 FT.  
(Use "+" if Above Top of Casing)

9. TOP OF CASING IS 1 FT. Above Land Surface\*  
\*Top of casing terminated at/or below land surface requires a variance in accordance with 15A NCAC 2C.0118  
 10. YIELD (gpm): 20 METHOD OF TEST Air  
 11. WATER ZONES (depth): 2.00 gpm 120-121 18.00 gpm 150-152  
0.00 gpm 0.00 gpm  
 12. CHLORINATION: Type HTH Amount 31

If additional space is needed use back of form

13. CASING:

From	To	Depth	Diameter	Wall Thickness or Weight/Ft.	Material
0	100	Ft.	8 1/4	125	Galv
100	165	Ft.			

**LOCATION SKETCH**

(Show direction and distance from at least two State Roads, or other map reference points)

14. GROUT:

From	To	Depth	Material	Method
0	20	Ft.	Cement	Gravity Flow


15. SCREEN:

From	To	Depth	Diameter	Slot Size	Material
		Ft.	in.	in.	

16. SAND/GRAVEL PACK:

From	To	Depth	Size	Material
		Ft.		

17. REMARKS: \_\_\_\_\_  
 I DO HEREBY CERTIFY THAT THIS WELL WAS CONSTRUCTED IN ACCORDANCE WITH 15A NCAC 2C, WELL CONSTRUCTION STANDARDS, AND THAT A COPY OF THIS RECORD HAS BEEN PROVIDED TO THE WELL OWNER.

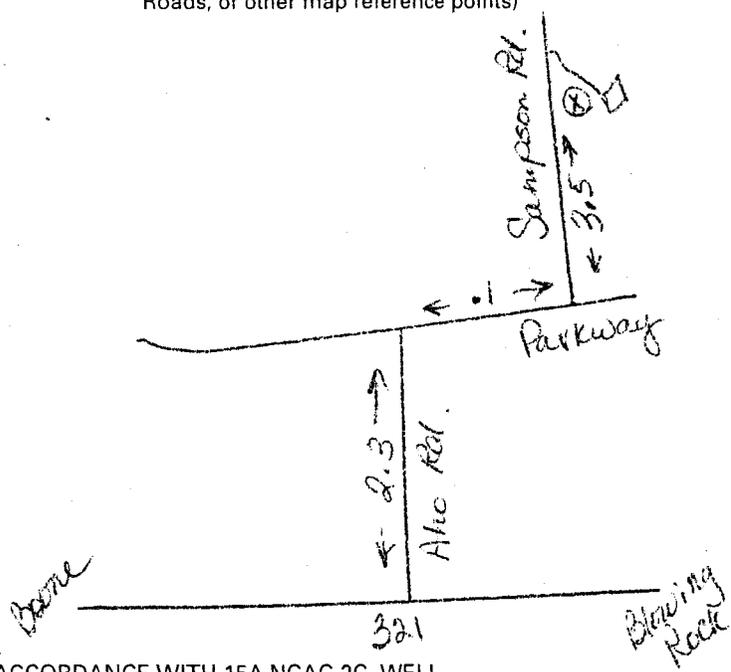

**FOR OFFICE USE ONLY**  
 Quad No: \_\_\_\_\_  
 Serial No. \_\_\_\_\_

SIGNATURE OF PERSON CONSTRUCTING THE WELL: Steve Pety DATE: 8-10-05  
 Submit original to Division of Water Quality, Groundwater Section within 30 days  
 GW-1 REV. 12/99