

237844

WELL CONSTRUCTION RECORD

010328

WELL CONTRACTOR: Dewey Wright Well Pump Co., Inc.
 WELL CONTRACTOR CERTIFICATION #: 2691
 STATE WELL CONSTRUCTION PERMIT#: Steve Petty

1. WELL USE (Check Applicable Box): Residential Municipal Industrial Agricultural Monitoring
 Recovery Heat Pump Water Injection Other If Other, List Use: _____


2. WELL LOCATION: (Show sketch of the location below)
 Nearest Town: BOONE County: AVERY
SPRINGWOOD OFF PINWOOD RD. OFF HOWARD CR
(Road Name and Numbers, Community, or Subdivision and Lot No.)

DRILLING LOG		DEPTH
From	To	Formation Description
0	50	DIRT
50	180	GRANITE
180	181	QUARTZ
181	390	GRANITE
390	392	QUARTZ
392	405	GRANITE

4. DATE DRILLED 8/9/2001
 5. TOTAL DEPTH 405
 6. CUTTINGS COLLECTED YES NO
 7. DOES WELL REPLACE EXISTING WELL? YES NO
 8. STATIC WATER LEVEL Below Top of Casing: 60 FT.
(Use "+" if Above Top of Casing)

9. TOP OF CASING IS 1 FT. Above Land Surface*
*Top of casing terminated at/or below land surface requires a variance in accordance with 15A NCAC 2C.0118
 10. YIELD (gpm): 4 METHOD OF TEST Air
 11. WATER ZONES (depth): 1 gpm 190-181 3 gpm 390-392
0 gpm 0 gpm

12. CHLORINATION: Type HTH Amount 70

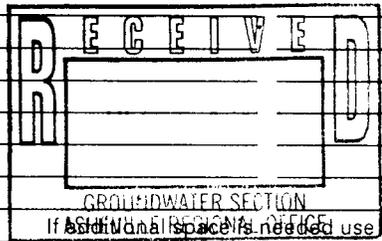

13. CASING:

From	To	Depth	Diameter	Wall Thickness or Weight/Ft.	Material
0	5	5 Ft.	6 1/8	.350	PVC
5	_____	_____ Ft.	_____	_____	_____
_____	_____	_____ Ft.	_____	_____	_____

14. GROUT:

From	To	Depth	Material	Method
0	20	20 Ft.	Cement	Gravity Flow
_____	_____	_____ Ft.	_____	_____


15. SCREEN:

From	To	Depth	Diameter	Slot Size	Material
_____	_____	_____ Ft.	_____ in.	_____ in.	_____
_____	_____	_____ Ft.	_____ in.	_____ in.	_____
_____	_____	_____ Ft.	_____ in.	_____ in.	_____

16. SAND/GRAVEL PACK:

From	To	Depth	Size	Material
_____	_____	_____ Ft.	_____	_____
_____	_____	_____ Ft.	_____	_____

17. REMARKS: _____
 I DO HEREBY CERTIFY THAT THIS WELL WAS CONSTRUCTED IN ACCORDANCE WITH 15A NCAC 2C, WELL CONSTRUCTION STANDARDS, AND THAT A COPY OF THIS RECORD HAS BEEN PROVIDED TO THE WELL OWNER.

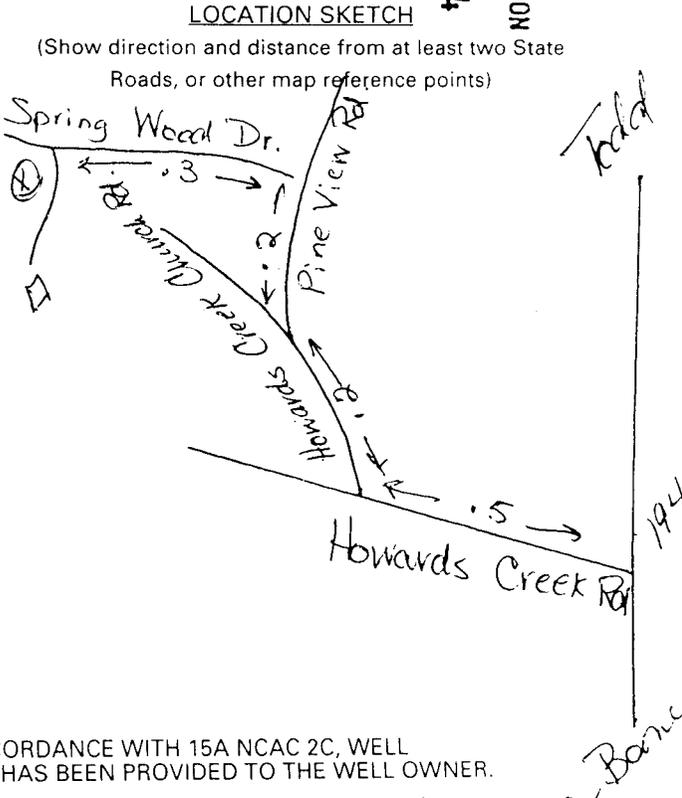

FOR OFFICE USE ONLY
 Quad No: _____
 Serial No: _____

Steve Petty
 SIGNATURE OF PERSON CONSTRUCTING THE WELL
 Submit original to Division of Water Quality, Groundwater Section within 30 days
 DATE 8-24-01
 GW-1 REV. 12/99