

292362

WELL CONSTRUCTION RECORD

WELL CONTRACTOR: Dewey Wright Well Pump Co., Inc.
 WELL CONTRACTOR CERTIFICATION #: 2686
 STATE WELL CONSTRUCTION PERMIT#: Leslie Reece

030021

1. WELL USE (Check Applicable Box): Residential Municipal Industrial Agricultural **RECEIVED**
 Recovery Heat Pump Water Injection Other If Other, List Use: N.C. Dept. of EHN

JUN 25 2004

2. WELL LOCATION: (Show sketch of the location below)
 Nearest Town: BOONE County: WATAUGA
WIND RIDGE RD. OFF MSAT GAP RD OFF HWY 321
(Road Name and Numbers, Community, or Subdivision and Lot No.)

Winston-Salem
 Regional Office
 DEPTH Information Description

DRILLING LOG		
From	To	Formation Description
0	17	DIRT
17	82	GRANITE
82	83	SHALE
83	244	GRANITE
244	245	SHALE
245	305	GRANITE

4. DATE DRILLED 1/8/2004
 5. TOTAL DEPTH 305
 6. CUTTINGS COLLECTED YES NO
 7. DOES WELL REPLACE EXISTING WELL? YES NO
 8. STATIC WATER LEVEL Below Top of Casing: 40 FT.
(Use "+" if Above Top of Casing)

9. TOP OF CASING IS 1 FT. Above Land Surface*
*Top of casing terminated at/or below land surface requires a variance in accordance with 15A NCAC 2C.0118
 10. YIELD (gpm): 12 METHOD OF TEST Air
 11. WATER ZONES (depth): 1.00 gpm 82-83 11.00 gpm 244-245
0.00 gpm 0.00 gpm


RECEIVED / DENR
 DWD GROUNDWATER SECTION
 04 JAN 29 PM 3:36

If additional space is needed use back of form

12. CHLORINATION: Type HTH Amount 54

LOCATION SKETCH

(Show direction and distance from at least two state roads, or other map reference points)

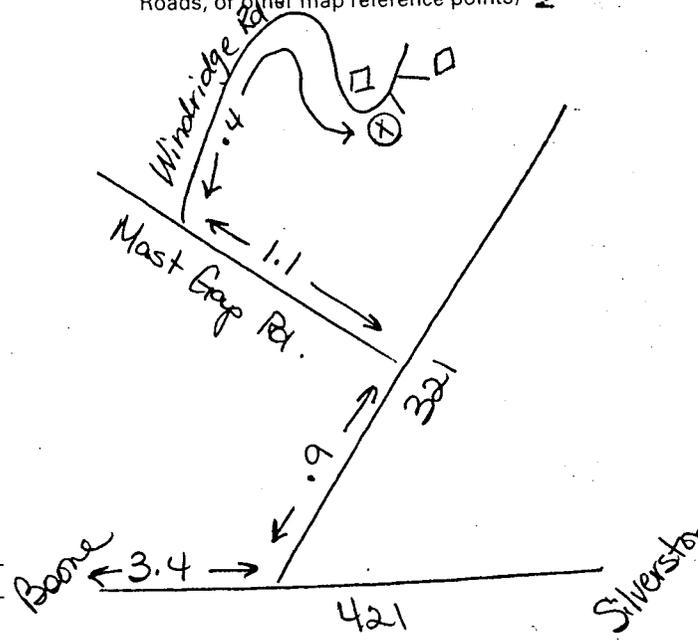

14. GROUT: Depth Material Method
 From 0 To 20 Ft. Cement Gravity Flow

15. SCREEN: Depth Diameter Slot Size Material
 From _____ To _____ Ft. _____ in. _____ in. _____
 From _____ To _____ Ft. _____ in. _____ in. _____
 From _____ To _____ Ft. _____ in. _____ in. _____

16. SAND/GRAVEL PACK: Depth Size Material
 From _____ To _____ Ft. _____ _____
 From _____ To _____ Ft. _____ _____

17. REMARKS: I DO HEREBY CERTIFY THAT THIS WELL WAS CONSTRUCTED IN ACCORDANCE WITH 15A NCAC 2C, WELL CONSTRUCTION STANDARDS, AND THAT A COPY OF THIS RECORD HAS BEEN PROVIDED TO THE WELL OWNER.

Wayne Reece

1-22-04

FOR OFFICE USE ONLY

Quad No: _____

Serial No. _____

SIGNATURE OF PERSON CONSTRUCTING THE WELL
 Submit original to Division of Water Quality, Groundwater Section within 30 days

DATE

GW-1 REV. 12/99