

294175

WELL CONSTRUCTION RECORD

040086

WELL CONTRACTOR: Dewey Wright Well Pump Co., Inc.
 WELL CONTRACTOR CERTIFICATION #: 2886
 STATE WELL CONSTRUCTION PERMIT#: Leslie Reece

1. WELL USE (Check Applicable Box): Residential Municipal Industrial Agricultural Monitoring
 Recovery Heat Pump Water Injection Other If Other, List Use: _____

RECEIVED
 N.C. Dept. of ENR
 AUG 05 2004

2. WELL LOCATION: (Show sketch of the location below)
 Nearest Town: DEEP GAP County: WATAUGA
ELK CREEK RD. OFF OLD 421 OFF HWY 421
(Road Name and Numbers, Community, or Subdivision and Lot No.)


DRILLING LOG		DEPTH	FORMATION DESCRIPTION
From	To		
0	42		DIRT
42	335		GRANITE
335	338		QUARTZ
338	365		GRANITE
		04 APR 28 AM 10 37	RECEIVED DIVISION OF WATER QUALITY

If additional space is needed use back of form

4. DATE DRILLED 3/24/2004
 5. TOTAL DEPTH 365
 6. CUTTINGS COLLECTED YES NO
 7. DOES WELL REPLACE EXISTING WELL? YES NO
 8. STATIC WATER LEVEL Below Top of Casing: 50 FT.
(Use "+" if Above Top of Casing)
 9. TOP OF CASING IS 1 FT. Above Land Surface*
*Top of casing terminated at/or below land surface requires a variance in accordance with 15A NCAC 2C.0118
 10. YIELD (gpm): 4 METHOD OF TEST Air
 11. WATER ZONES (depth): 4.00 gpm 335-338 0.00 gpm
0.00 gpm 0.00 gpm
 12. CHLORINATION: Type HTH Amount 65

13. CASING:

From	Depth	To	Diameter	Wall Thickness or Weight/Ft.	Material
0		48 Ft.	6 1/8	.350	PVC

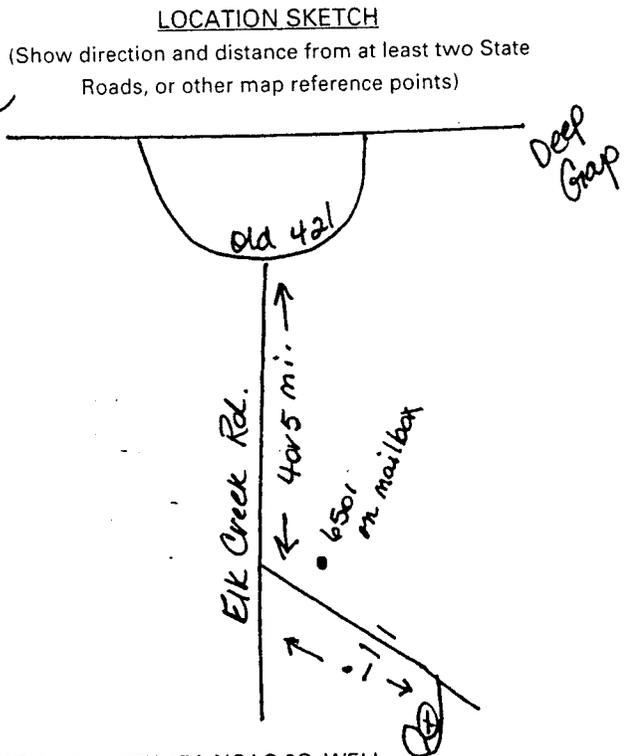

14. GROUT:

From	Depth	To	Material	Method
0		20 Ft.	Cement	Gravity Flow

15. SCREEN:

From	Depth	To	Diameter	Slot Size	Material

16. SAND/GRAVEL PACK:

From	Depth	To	Size	Material

17. REMARKS: _____
 I DO HEREBY CERTIFY THAT THIS WELL WAS CONSTRUCTED IN ACCORDANCE WITH 15A NCAC 2C, WELL CONSTRUCTION STANDARDS, AND THAT A COPY OF THIS RECORD HAS BEEN PROVIDED TO THE WELL OWNER.

FOR OFFICE USE ONLY
 Quad No: _____

Leslie Reece 4-23-04
 SIGNATURE OF PERSON CONSTRUCTING THE WELL DATE
 Submit original to Division of Water Quality, Groundwater Section within 30 days
 GW-1 REV. 12/99