

294176

WELL CONSTRUCTION RECORD

WELL CONTRACTOR: Dewey Wright Well Pump Co., Inc.
 WELL CONTRACTOR CERTIFICATION #: 2686
 STATE WELL CONSTRUCTION PERMIT#: Leslie Reece

040104

1. WELL USE (Check Applicable Box): Residential Municipal Industrial Agricultural Monitoring
 Recovery Heat Pump Water Injection Other If Other, List Use: _____

2. WELL LOCATION: (Show sketch of the location below)
 Nearest Town: ELK MILLS County: WATAUGA
PRIVATE DR. OFF HWY 321 OFF HWY 421
(Road Name and Numbers, Community, or Subdivision and Lot No.)

RECEIVED
 N.C. Dept. of ENR
 AUG 05 2004

DRILLING LOG

From	To	FORMATION DESCRIPTION
0	10	DIRT
10	130	GRANITE
130	131	SHALE
131	258	GRANITE
258	259	SHALE
259	405	GRANITE

Winston-Salem
 REGIONAL OFFICE
 DEPT. OF ENVIRONMENT AND NATURAL RESOURCES
 DIVISION OF GROUNDWATER SECTION

RECEIVED/ENR
 DIVISION OF GROUNDWATER SECTION
 APR 23 AM 10:58

4. DATE DRILLED 3/26/2004
 5. TOTAL DEPTH 405
 6. CUTTINGS COLLECTED YES NO
 7. DOES WELL REPLACE EXISTING WELL? YES NO
 8. STATIC WATER LEVEL Below Top of Casing: 60 FT.
(Use "+" if Above Top of Casing)

9. TOP OF CASING IS 1 FT. Above Land Surface*
*Top of casing terminated at/or below land surface requires a variance in accordance with 15A NCAC 2C.0118

10. YIELD (gpm): 2 METHOD OF TEST Air
 11. WATER ZONES (depth): 0.50 gpm 130-131 1.50 gpm 258-259
0.00 gpm 0.00 gpm


12. CHLORINATION: Type HTH Amount 70

If additional space is needed use back of form

13. CASING:
 Depth Diameter Wall Thickness or Weight/Ft. Material
 From 0 To 21 Ft. 6 1/4 .188 GALV.
 From _____ To _____ Ft. _____ _____ _____
 From _____ To _____ Ft. _____ _____ _____

LOCATION SKETCH

(Show direction and distance from at least two State Roads, or other map reference points)

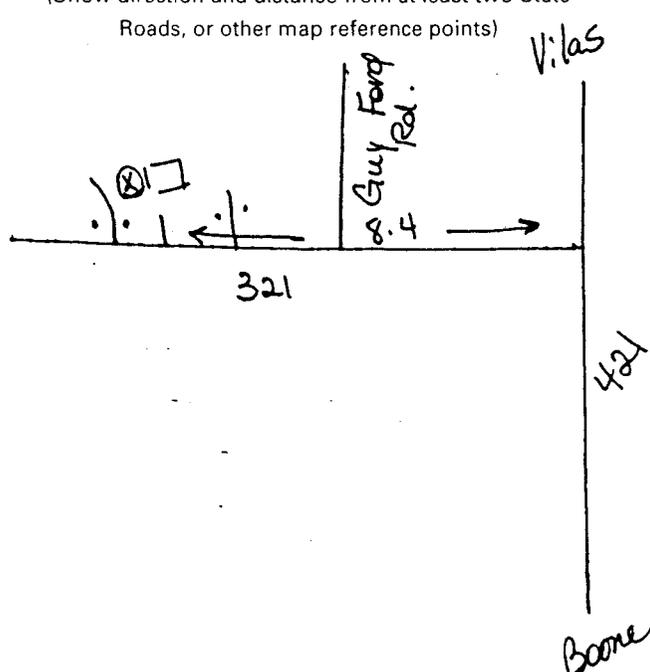

14. GROUT:
 Depth Material Method
 From 0 To 20 Ft. Cement Gravity Flow
 From _____ To _____ Ft. _____ _____

15. SCREEN:
 Depth Diameter Slot Size Material
 From _____ To _____ Ft. _____ in. _____ in. _____
 From _____ To _____ Ft. _____ in. _____ in. _____
 From _____ To _____ Ft. _____ in. _____ in. _____

16. SAND/GRAVEL PACK:
 Depth Size Material
 From _____ To _____ Ft. _____ _____
 From _____ To _____ Ft. _____ _____

17. REMARKS: _____

I DO HEREBY CERTIFY THAT THIS WELL WAS CONSTRUCTED IN ACCORDANCE WITH 15A NCAC 2C, WELL CONSTRUCTION STANDARDS, AND THAT A COPY OF THIS RECORD HAS BEEN PROVIDED TO THE WELL OWNER.

Wayne Reece 4-23-04

SIGNATURE OF PERSON CONSTRUCTING THE WELL
 Submit original to Division of Water Quality, Groundwater Section within 30 days

DATE

FOR OFFICE USE ONLY
 Quad No: _____
 Serial No. _____