

295306

WELL CONSTRUCTION RECORD

WELL CONTRACTOR: Dewey Wright Well Pump Co., Inc.
 WELL CONTRACTOR CERTIFICATION #: 2878
 STATE WELL CONSTRUCTION PERMIT#: Steve Price

040205

1. WELL USE (Check Applicable Box): Residential Municipal Industrial
 Recovery Heat Pump Water Injection Other If Other, List Use: _____
 Agricultural Monitoring

AUG 06 2004

2. WELL LOCATION: (Show sketch of the location below)
 Nearest Town: BOONE County: WATAUGA
HOWARDS CREEK RD. OFF HWY 194 OFF HWY 421
(Road Name and Numbers, Community, or Subdivision and Lot No.)

Winston-Salem
 Regional Office

DRILLING LOG

From	To	Formation Description
0	18	DIRT
18	90	GRANITE
90	91	GRANITE
91	130	GRANITE
130	131	GRANITE
131	145	GRANITE

4. DATE DRILLED 5/20/2004
 5. TOTAL DEPTH 145
 6. CUTTINGS COLLECTED YES NO
 7. DOES WELL REPLACE EXISTING WELL? YES NO
 8. STATIC WATER LEVEL Below Top of Casing: 20 FT.
(Use "+" if Above Top of Casing)

9. TOP OF CASING IS 1 FT. Above Land Surface*
*Top of casing terminated at/or below land surface requires a variance in accordance with 15A NCAC 2C.0118


10. YIELD (gpm): 2 METHOD OF TEST Air
 11. WATER ZONES (depth): 1.00 gpm 90-91 1.00 gpm 130-131
0.00 gpm 0.00 gpm

12. CHLORINATION: Type HTH Amount 26

If additional space is needed use back of form

LOCATION SKETCH

(Show direction and distance from at least two State Roads, or other map reference points)

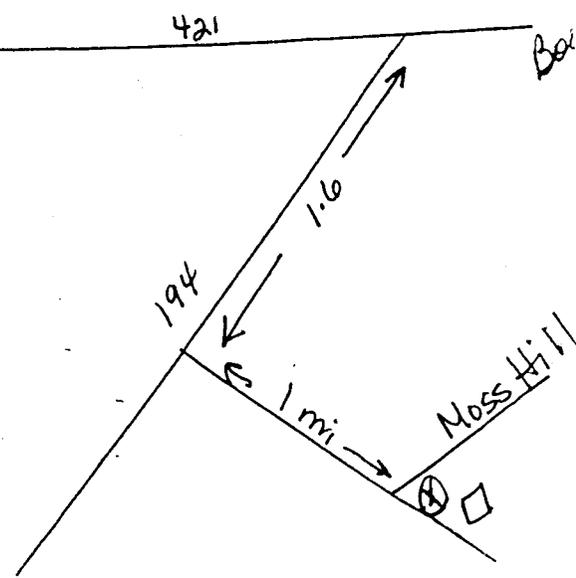

13. CASING:
- | From | To | Depth | Diameter | Wall Thickness or Weight/Ft. | Material |
|------|----|-------|----------|------------------------------|----------|
| 0 | 24 | Ft. | 8 1/8 | 350 | PVC |
| From | To | Ft. | | | |
| From | To | Ft. | | | |

14. GROUT:
- | From | To | Depth | Material | Method |
|------|----|-------|----------|--------------|
| 0 | 20 | Ft. | Cement | Gravity Flow |
| From | To | Ft. | | |

15. SCREEN:
- | From | To | Depth | Diameter | Slot Size | Material |
|------|----|-------|----------|-----------|----------|
| From | To | Ft. | in. | in. | |
| From | To | Ft. | in. | in. | |
| From | To | Ft. | in. | in. | |

16. SAND/GRAVEL PACK:
- | From | To | Depth | Size | Material |
|------|----|-------|------|----------|
| From | To | Ft. | | |
| From | To | Ft. | | |

17. REMARKS: _____
 I DO HEREBY CERTIFY THAT THIS WELL WAS CONSTRUCTED IN ACCORDANCE WITH 15A NCAC 2C, WELL CONSTRUCTION STANDARDS, AND THAT A COPY OF THIS RECORD HAS BEEN PROVIDED TO THE WELL OWNER.

Steven Price

SIGNATURE OF PERSON CONSTRUCTING THE WELL
 Submit original to Division of Water Quality, Groundwater Section within 30 days

DATE
 GW-1 REV. 12/99

FOR OFFICE USE ONLY
 Quad No: _____
 Serial No. _____