

296287

WELL CONSTRUCTION RECORD

WELL CONTRACTOR: Dewey Wright Well Pump Co., Inc.
 WELL CONTRACTOR CERTIFICATION #: 2687
 STATE WELL CONSTRUCTION PERMIT#: Steve Reece

040123

1. WELL USE (Check Applicable Box): Residential Municipal Industrial Agricultural Monitoring
 Recovery Heat Pump Water Injection Other If Other, List Use: _____

RECEIVED
 N.C. Dept. of EHN
 AUG 06 2004

2. WELL LOCATION: (Show sketch of the location below)
 Nearest Town: TODD County: WATAUGA
LOG HOLLOW OFF PROFFITT RD. OFF MEAT CAMP RD
(Road Name and Numbers, Community, or Subdivision and Lot No.)

DRILLING LOG

From	To	Formation Description
0	20	DIRT
20	110	GRANITE
110	112	QUARTZ
112	400	GRANITE

Winston-Salem
 REGIONAL OFFICE

4. DATE DRILLED 4/22/2004
 5. TOTAL DEPTH 400
 6. CUTTINGS COLLECTED YES NO
 7. DOES WELL REPLACE EXISTING WELL? YES NO
 8. STATIC WATER LEVEL Below Top of Casing: 80 FT.
(Use "*" if Above Top of Casing)

9. TOP OF CASING IS 1 FT. Above Land Surface*
*Top of casing terminated at/or below land surface requires a variance in accordance with 15A NCAC 2C.0118

10. YIELD (gpm): 1.5 METHOD OF TEST Air
 11. WATER ZONES (depth): 1.50 gpm 110-112 0.00 gpm
0.00 gpm 0.00 gpm

12. CHLORINATION: Type HTH Amount 66

13. CASING:

From	To	Depth	Diameter	Wall Thickness or Weight/Ft.	Material
0	35	Ft.	6 1/8	350	PVC
35		Ft.			
		Ft.			

14. GROUT:

From	To	Depth	Material	Method
0	20	Ft.	Cement	Gravity Flow
20		Ft.		
		Ft.		


15. SCREEN:

From	To	Depth	Diameter	Slot Size	Material
		Ft.	in.	in.	
		Ft.	in.	in.	
		Ft.	in.	in.	

16. SAND/GRAVEL PACK:

From	To	Depth	Size	Material
		Ft.		
		Ft.		

17. REMARKS:
 I DO HEREBY CERTIFY THAT THIS WELL WAS CONSTRUCTED IN ACCORDANCE WITH 15A NCAC 2C, WELL CONSTRUCTION STANDARDS, AND THAT A COPY OF THIS RECORD HAS BEEN PROVIDED TO THE WELL OWNER.

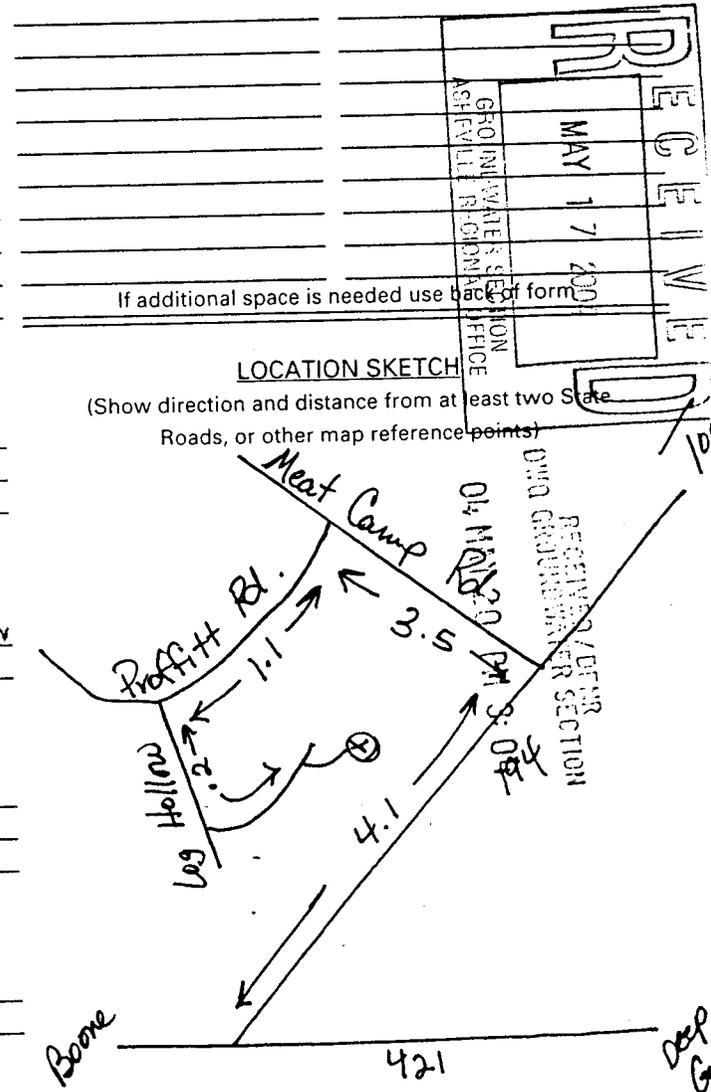

FOR OFFICE USE ONLY
 Quad No: _____
 Serial No. _____

Steve Reece 5-14-04
 SIGNATURE OF PERSON CONSTRUCTING THE WELL DATE
 Submit original to Division of Water Quality, Groundwater Section within 30 days GW-1 REV. 12/99