

296290

WELL CONSTRUCTION RECORD

WELL CONTRACTOR: Dewey Wright Well Pump Co., Inc.
 WELL CONTRACTOR CERTIFICATION #: 2687
 STATE WELL CONSTRUCTION PERMIT#: Steve Reece

040154

1. WELL USE (Check Applicable Box): Residential Municipal Industrial Agricultural Monitoring
 Recovery Heat Pump Water Injection Other If Other, List Use: _____

RECEIVED
 N.C. Dept. of ENR
 AUG 06 2004

2. WELL LOCATION: (Show sketch of the location below)
 Nearest Town: BOONE County: WATAUGA
CANTER RD OFF MEAT CAMP RD OFF HWY 194 OFF H
(Road Name and Numbers, Community, or Subdivision and Lot No.)

Winston-Salem
 Regional Office

DRILLING LOG

From	To	Formation Description
0	50	DIRT
50	100	GRANITE
100	103	QUARTZ
103	120	GRANITE

4. DATE DRILLED 4/22/2004
 5. TOTAL DEPTH 120
 6. CUTTINGS COLLECTED YES NO
 7. DOES WELL REPLACE EXISTING WELL? YES NO
 8. STATIC WATER LEVEL Below Top of Casing: 20 FT.
(Use "+" if Above Top of Casing)

9. TOP OF CASING IS 1 FT. Above Land Surface*
*Top of casing terminated at/or below land surface requires a variance in accordance with 15A NCAC 2C.0118


10. YIELD (gpm): 30 METHOD OF TEST Air
 11. WATER ZONES (depth): 30.00 gpm 100-103 0.00 gpm
0.00 gpm 0.00 gpm

12. CHLORINATION: Type HTH Amount 21

13. CASING:

From	To	Depth	Diameter	Wall Thickness or Weight/Ft.	Material
0	58	Ft.	8 1/4	188	GALV
From	To	Ft.			
From	To	Ft.			

LOCATION SKETCH
 (Show direction and distance from at least two State Roads, or other map reference points)

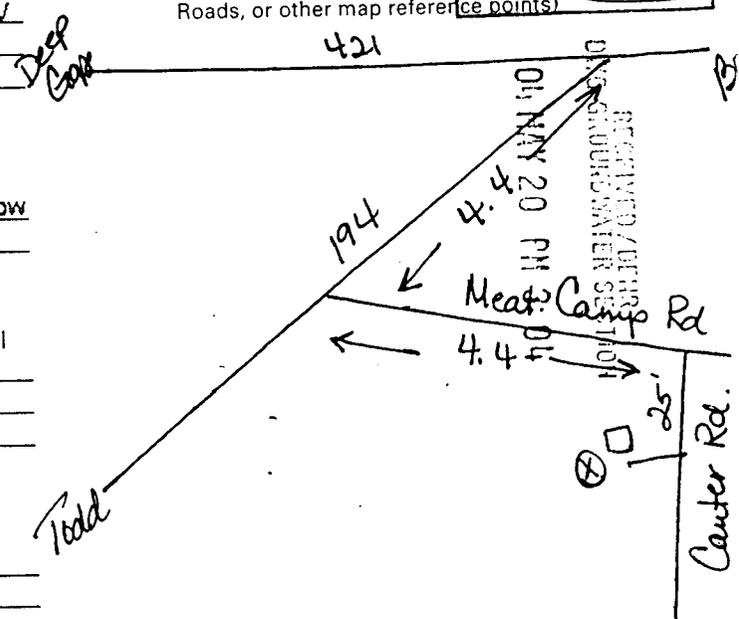

14. GROUT:

From	To	Depth	Material	Method
0	20	Ft.	Cement	Gravity Flow
From	To	Ft.		

15. SCREEN:

From	To	Depth	Diameter	Slot Size	Material
From	To	Ft.	in.	in.	
From	To	Ft.	in.	in.	
From	To	Ft.	in.	in.	

16. SAND/GRAVEL PACK:

From	To	Depth	Size	Material
From	To	Ft.		
From	To	Ft.		

17. REMARKS: _____
 I DO HEREBY CERTIFY THAT THIS WELL WAS CONSTRUCTED IN ACCORDANCE WITH 15A NCAC 2C, WELL CONSTRUCTION STANDARDS, AND THAT A COPY OF THIS RECORD HAS BEEN PROVIDED TO THE WELL OWNER.

Steve Reece 5-14-04
 SIGNATURE OF PERSON CONSTRUCTING THE WELL DATE

FOR OFFICE USE ONLY
 Quad No: _____
 Serial No. _____