

296294

# WELL CONSTRUCTION RECORD

WELL CONTRACTOR: Dewey Wright Well Pump Co., Inc.  
 WELL CONTRACTOR CERTIFICATION #: 2878  
 STATE WELL CONSTRUCTION PERMIT#: Steve Price

040145

1. WELL USE (Check Applicable Box): Residential  Municipal  Industrial  Agricultural  Monitoring   
 Recovery  Heat Pump Water Injection  Other  If Other, List Use: \_\_\_\_\_

RECEIVED  
 N.C. Dept. of ENR  
 AUG 06 2004

2. WELL LOCATION: (Show sketch of the location below)  
 Nearest Town: FOSCOE County: WATAUGA  
LOWER CRAB ORCHARD RD. OFF HWY 194 OFF BROAD  
(Road Name and Numbers, Community, or Subdivision and Lot No.)

DRILLING LOG		FORMATION DESCRIPTION
From	To	
0	58	DIRT MUD
58	70	GRANITE
70	71	SHALE
71	100	GRANITE
100	101	QUARTZ
101	130	GRANITE
130	131	QUARTZ
131	145	GRANITE

Winston-Salem  
 Regional Office  
 Formation Description

4. DATE DRILLED 4/23/2004  
 5. TOTAL DEPTH 145  
 6. CUTTINGS COLLECTED YES  NO   
 7. DOES WELL REPLACE EXISTING WELL? YES  NO   
 8. STATIC WATER LEVEL Below Top of Casing: 50 FT.  
(Use "+" if Above Top of Casing)

9. TOP OF CASING IS 1 FT. Above Land Surface\*  
\*Top of casing terminated at/or below land surface requires a variance in accordance with 15A NCAC 2C.0118  
 10. YIELD (gpm): 8 METHOD OF TEST Air  
 11. WATER ZONES (depth): 0.50 gpm 70-71 0.50 gpm 100-101  
7.00 gpm 130-131 0.00 gpm  
 12. CHLORINATION: Type HTH Amount 20

13. CASING:

From	To	Depth	Diameter	Wall Thickness or Weight/Ft.	Material
0	67	Ft.	6 1/8	.350	PVC
67	145	Ft.			

LOCATION SKETCH  
 (Show direction and distance from at least two State Roads, or other map reference points)

14. GROUT:

From	To	Depth	Material	Method
0	20	Ft.	Cement	Gravity Flow
20	145	Ft.		


15. SCREEN:

From	To	Depth	Diameter	Slot Size	Material
		Ft.	in.	in.	
		Ft.	in.	in.	
		Ft.	in.	in.	

16. SAND/GRAVEL PACK:

From	To	Depth	Size	Material
		Ft.		
		Ft.		

17. REMARKS: \_\_\_\_\_  
 I DO HEREBY CERTIFY THAT THIS WELL WAS CONSTRUCTED IN ACCORDANCE WITH 15A NCAC 2C, WELL CONSTRUCTION STANDARDS, AND THAT A COPY OF THIS RECORD HAS BEEN PROVIDED TO THE WELL OWNER.

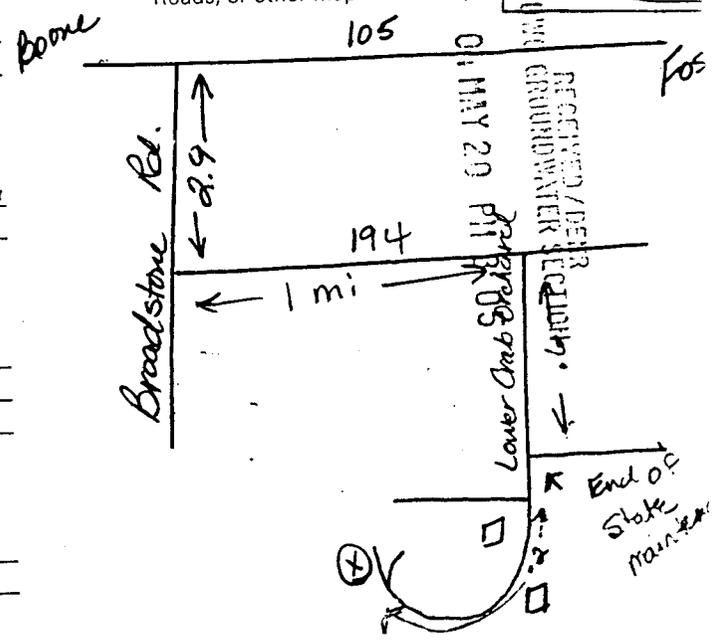

FOR OFFICE USE ONLY  
 Quad No: \_\_\_\_\_  
 Serial No: \_\_\_\_\_

Steve Price  
 SIGNATURE OF PERSON CONSTRUCTING THE WELL  
 Submit original to Division of Water Quality, Groundwater Section within 30 days  
 DATE 5-14-04  
 GW-1 REV. 12/99