

296295

# WELL CONSTRUCTION RECORD

WELL CONTRACTOR: Dewey Wright Well Pump Co., Inc.  
WELL CONTRACTOR CERTIFICATION #: 2878  
STATE WELL CONSTRUCTION PERMIT#: Steve Price

040159

RECEIVED

1. WELL USE (Check Applicable Box): Residential  Municipal  Industrial  Agricultural  Monitoring   
Recovery  Heat Pump Water Injection  Other  If Other, List Use: \_\_\_\_\_

AUG 06 2004

2. WELL LOCATION: (Show sketch of the location below)  
Nearest Town: BOONE County: WATAUGA  
CRESTVIEW LANE OFF CENTER COURT OFF SAMPSON  
(Road Name and Numbers, Community, or Subdivision and Lot No.)

Winston-Salem  
Regional Office

### DRILLING LOG

### DEPTH

From	To	Formation Description
0	30	DIRT
30	105	GRANITE
105	108	QUARTZ
108	170	GRANITE
170	171	QUARTZ
171	210	GRANITE
210	211	QUARTZ
211	225	GRANITE

4. DATE DRILLED 4/27/2004  
5. TOTAL DEPTH 225  
6. CUTTINGS COLLECTED YES  NO   
7. DOES WELL REPLACE EXISTING WELL? YES  NO   
8. STATIC WATER LEVEL Below Top of Casing: 36 FT.  
(Use "+" if Above Top of Casing)

9. TOP OF CASING IS 1 FT. Above Land Surface\*  
\*Top of casing terminated at/or below land surface requires a variance in accordance with 15A NCAC 2C.0118

10. YIELD (gpm): 4 METHOD OF TEST Air  
11. WATER ZONES (depth): 0.50 gpm 105-108 0.50 gpm 170-171  
3.00 gpm 210-211 0.00 gpm

12. CHLORINATION: Type HTH Amount 30

13. CASING:

From	To	Depth	Diameter	Wall Thickness or Weight/Ft.	Material
0	36	Ft.	6 1/8	350	PVC
From	To	Ft.			
From	To	Ft.			

14. GROUT:

From	To	Depth	Material	Method
0	20	Ft.	Cement	Gravity Flow
From	To	Ft.		


15. SCREEN:

From	To	Depth	Diameter	Slot Size	Material
From	To	Ft.	in.	in.	
From	To	Ft.	in.	in.	
From	To	Ft.	in.	in.	

16. SAND/GRAVEL PACK:

From	To	Depth	Size	Material
From	To	Ft.		
From	To	Ft.		

17. REMARKS: \_\_\_\_\_

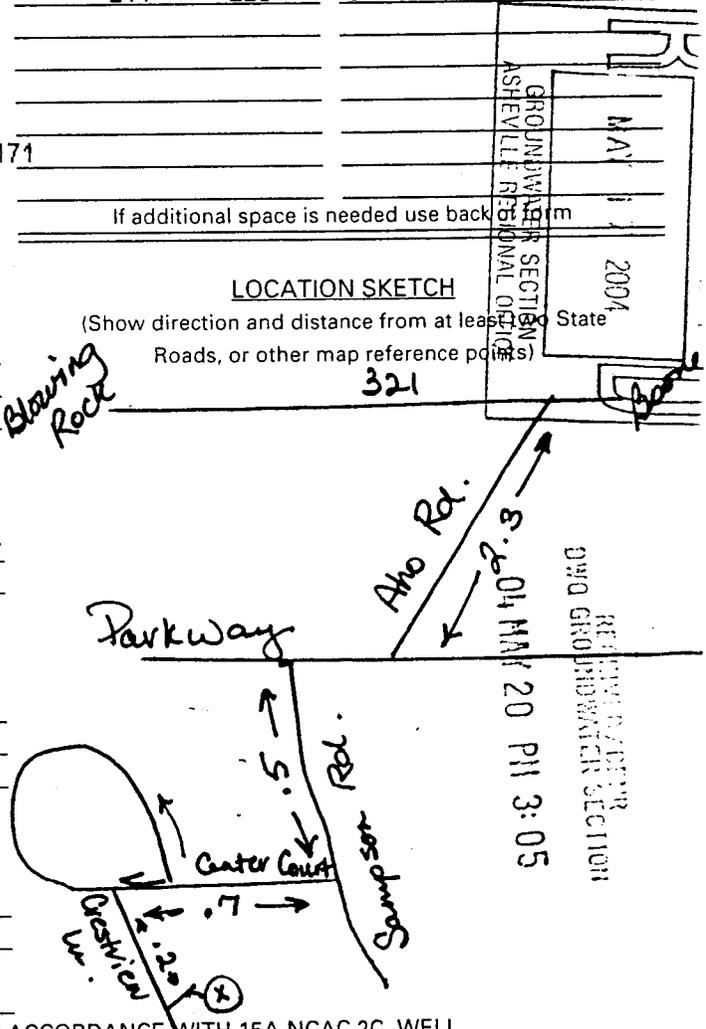

I DO HEREBY CERTIFY THAT THIS WELL WAS CONSTRUCTED IN ACCORDANCE WITH 15A NCAC 2C, WELL CONSTRUCTION STANDARDS, AND THAT A COPY OF THIS RECORD HAS BEEN PROVIDED TO THE WELL OWNER.

FOR OFFICE USE ONLY

Quad No: \_\_\_\_\_

Steven Price SIGNATURE OF PERSON CONSTRUCTING THE WELL DATE 5-14-04  
Submit original to Division of Water Quality, Groundwater Section within 30 days GW-1 REV. 12/99