

296323

WELL CONSTRUCTION RECORD

WELL CONTRACTOR: Dewey Wright Well Pump Co., Inc.
 WELL CONTRACTOR CERTIFICATION #: 2797
 STATE WELL CONSTRUCTION PERMIT#: Jerry Wilson

040170

RECEIVED

1. WELL USE (Check Applicable Box): Residential Municipal Industrial Agricultural Municipal Other If Other, List Use: _____

AUG 06 2004

2. WELL LOCATION: (Show sketch of the location below)
 Nearest Town: DEEP GAP County: WATAUGA
JOE GREER RD. OFF DEEP GAP DR. OFF OLD 421 OFF
(Road Name and Numbers, Community, or Subdivision and Lot No.)

Winston-Salem
 Regional Office

DRILLING LOG

DEPTH

From	To	Formation Description
0	10	DIRT SHALE
10	38	SHALE GRANITE
38	39	SHALE
39	52	SHALE GRANITE QUARTZ
52	53	QUARTZ
53	105	GRANITE QUARTZ
105	106	QUARTZ
106	185	GRANITE QUARTZ

4. DATE DRILLED 5/4/2004
 5. TOTAL DEPTH 185
 6. CUTTINGS COLLECTED YES NO
 7. DOES WELL REPLACE EXISTING WELL? YES NO
 8. STATIC WATER LEVEL Below Top of Casing: 10 FT.
(Use "+" if Above Top of Casing)
 9. TOP OF CASING IS 1 FT. Above Land Surface*
*Top of casing terminated at/or below land surface requires a variance in accordance with 15A NCAC 2C.0118
 10. YIELD (gpm): 20 METHOD OF TEST Air
 11. WATER ZONES (depth): 3.00 gpm 38-39 2.00 gpm 52-53
15.00 gpm 105-106 0.00 gpm
 12. CHLORINATION: Type HTH Amount 36


13. CASING:
 From 0 To 21 Ft. Depth 6 1/8 Diameter .350 Wall Thickness or Weight/Ft. PVC Material

14. GROUT:
 From 0 To 20 Ft. Depth Cement Material Gravity Flow Method

15. SCREEN:
 From _____ To _____ Ft. Depth _____ Diameter _____ Slot Size _____ Material

16. SAND/GRAVEL PACK:
 From _____ To _____ Ft. Depth _____ Size _____ Material

17. REMARKS: _____

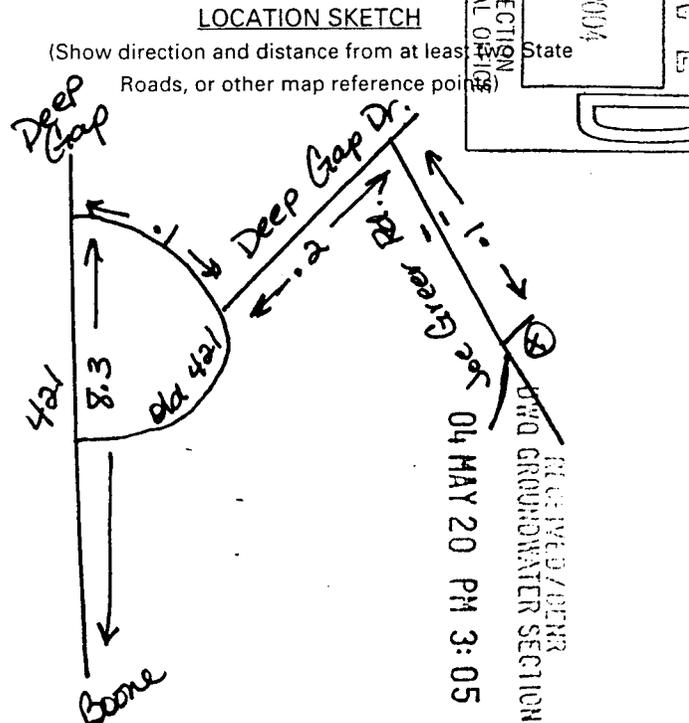

I DO HEREBY CERTIFY THAT THIS WELL WAS CONSTRUCTED IN ACCORDANCE WITH 15A NCAC 2C, WELL CONSTRUCTION STANDARDS, AND THAT A COPY OF THIS RECORD HAS BEEN PROVIDED TO THE WELL OWNER.

Jerry Wilson 5-14-2004
 SIGNATURE OF PERSON CONSTRUCTING THE WELL DATE

FOR OFFICE USE ONLY
 Quad No: _____
 Serial No. _____