

296324

WELL CONSTRUCTION RECORD

WELL CONTRACTOR: Dewey Wright Well Pump Co., Inc.
 WELL CONTRACTOR CERTIFICATION #: 2797
 STATE WELL CONSTRUCTION PERMIT#: Jerry Wilson

040047

1. WELL USE (Check Applicable Box): Residential Municipal Industrial Agricultural Monitoring
 Recovery Heat Pump Water Injection Other If Other, List Use: _____

RECEIVED
 N.C. Department of Environment and Natural Resources

AUG 06 2004

2. WELL LOCATION: (Show sketch of the location below)
 Nearest Town: BOONE County: WATAUGA
SLEEPY HOLLOW DR. OFF BAMBOO RD. OFF HWY 421
(Road Name and Numbers, Community, or Subdivision and Lot No.)

Winston-Salem
 Regional Office

DRILLING LOG		DEPTH
From	To	Formation Description
0	55	DIRT SHALE QUARTZ
55	90	GRANITE SHALE
90	91	GRANITE
91	250	GRANITE QUARTZ
250	251	GRANITE
251	390	GRANITE QUARTZ
390	391	GRANITE
391	465	GRANITE

4. DATE DRILLED 5/3/2004
 5. TOTAL DEPTH 465
 6. CUTTINGS COLLECTED YES NO
 7. DOES WELL REPLACE EXISTING WELL? YES NO
 8. STATIC WATER LEVEL Below Top of Casing: 50 FT.
(Use "+" if Above Top of Casing)

9. TOP OF CASING IS 1 FT. Above Land Surface*
*Top of casing terminated at/or below land surface requires a variance in accordance with 15A NCAC 2C.0118

10. YIELD (gpm): 3 METHOD OF TEST Air
 11. WATER ZONES (depth): 1.00 gpm 90-91 0.50 gpm 250-251
1.50 gpm 390-391 0.00 gpm

12. CHLORINATION: Type HTH Amount 86

13. CASING:

From	Depth	To	Diameter	Wall Thickness or Weight/Ft.	Material
0		62	6 1/8	.350	PVC
From		To	Ft.		
From		To	Ft.		

14. GROUT:

From	Depth	To	Material	Method
0		20	Cement	Gravity Flow
From		To	Ft.	

15. SCREEN:


From	Depth	To	Diameter	Slot Size	Material
From		To	Ft.	in.	in.
From		To	Ft.	in.	in.
From		To	Ft.	in.	in.

16. SAND/GRAVEL PACK:

From	Depth	To	Size	Material
From		To	Ft.	
From		To	Ft.	

17. REMARKS: _____

LOCATION SKETCH
 (Show direction and distance from at least two State Roads, or other map reference points)

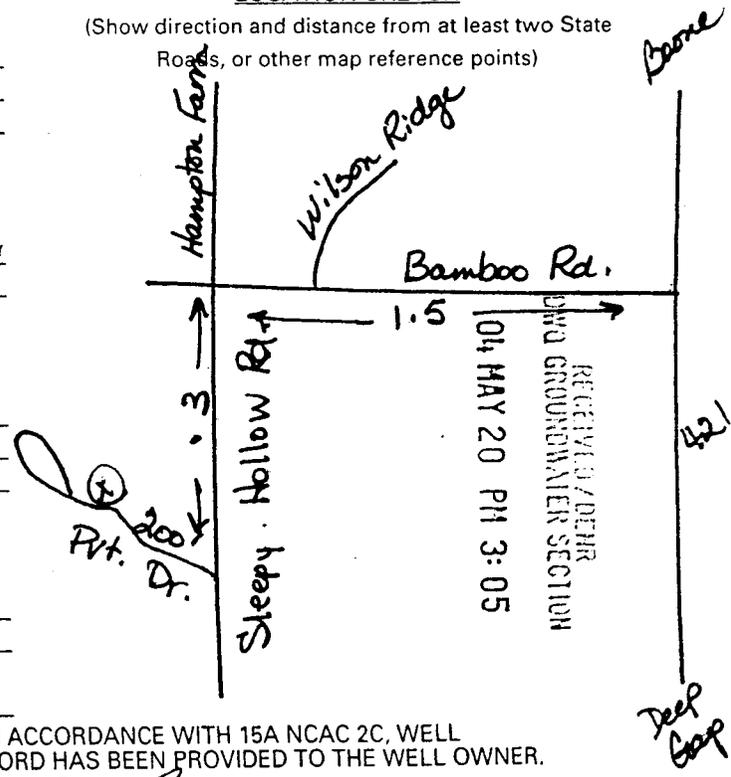

I DO HEREBY CERTIFY THAT THIS WELL WAS CONSTRUCTED IN ACCORDANCE WITH 15A NCAC 2C, WELL CONSTRUCTION STANDARDS, AND THAT A COPY OF THIS RECORD HAS BEEN PROVIDED TO THE WELL OWNER.

Jerry Wilson 5-14-2004
 SIGNATURE OF PERSON CONSTRUCTING THE WELL DATE

FOR OFFICE USE ONLY
 Quad No: _____
 Serial No. _____