

286325

WELL CONSTRUCTION RECORD

WELL CONTRACTOR: Dewey Wright Well Pump Co., Inc.
 WELL CONTRACTOR CERTIFICATION #: 2797
 STATE WELL CONSTRUCTION PERMIT#: Jerry Wilson

030545

RECEIVED
 N.C. Dept. of ENR

AUG 06 2004

Winston-Salem
 Regional Office

1. WELL USE (Check Applicable Box): Residential Municipal Industrial
 Recovery Heat Pump Water Injection Other If Other, List Use: _____

Agricultural Monitoring

2. WELL LOCATION: (Show sketch of the location below)

Nearest Town: DEEP GAP County: WATAUGA
OFF ROURKE RIDGE OFF RIDGEWOOD RD OFF HWY 4
(Road Name and Numbers, Community, or Subdivision and Lot No.)

DRILLING LOG

From	To	Formation Description
0	32	DIRT SHALE GRANITE
32	75	GRANITE SHALE
75	78	SHALE QUARTZ
78	375	GRANITE QUARTZ
375	405	GRANITE

4. DATE DRILLED: 5/7/2004
 5. TOTAL DEPTH: 405
 6. CUTTINGS COLLECTED YES NO
 7. DOES WELL REPLACE EXISTING WELL? YES NO
 8. STATIC WATER LEVEL Below Top of Casing: 50 FT.
(Use "+" if Above Top of Casing)

9. TOP OF CASING IS 1 FT. Above Land Surface*
*Top of casing terminated at/or below land surface requires a variance in accordance with 15A NCAC 2C.0118

10. YIELD (gpm): 20 METHOD OF TEST Air
 11. WATER ZONES (depth): 1.00 gpm 75-78 19.00 gpm 375-376
0.00 gpm 0.00 gpm


12. CHLORINATION: Type HTH Amount 71

RECEIVED
 MAY 17 2004
 REGIONAL WATER SECTION
 WINSTON-SALEM REGIONAL OFFICE

13. CASING:

From	Depth	To	Diameter	Wall Thickness or Weight/Ft.	Material
0		41 Ft.	6 1/8	.350	PVC
From		To			
From		To			

LOCATION SKETCH
 (Show direction and distance from at least two State Roads, or other map reference points)

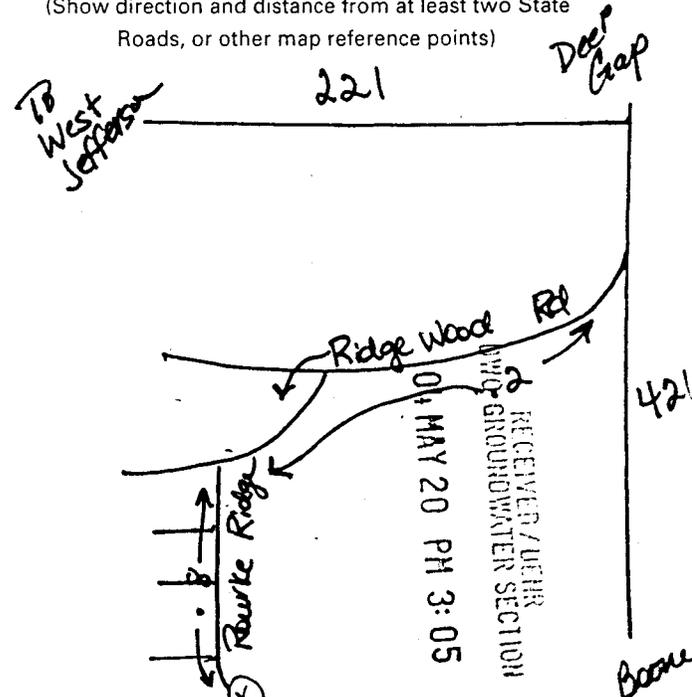

14. GROUT:

From	Depth	To	Material	Method
0		20 Ft.	Cement	Gravity Flow
From		To		

15. SCREEN:

From	Depth	To	Diameter	Slot Size	Material
From		To			
From		To			
From		To			

16. SAND/GRAVEL PACK:

From	Depth	To	Size	Material
From		To		
From		To		

17. REMARKS: _____

I DO HEREBY CERTIFY THAT THIS WELL WAS CONSTRUCTED IN ACCORDANCE WITH 15A NCAC 2C, WELL CONSTRUCTION STANDARDS, AND THAT A COPY OF THIS RECORD HAS BEEN PROVIDED TO THE WELL OWNER.

Marye Wilson 5-14-2004

SIGNATURE OF PERSON CONSTRUCTING THE WELL DATE

Submit original to Division of Water Quality, Groundwater Section within 30 days

FOR OFFICE USE ONLY
 Quad No: _____
 Serial No. _____