

296326

WELL CONSTRUCTION RECORD

WELL CONTRACTOR: Dewey Wright Well Pump Co., Inc.
 WELL CONTRACTOR CERTIFICATION #: 2797
 STATE WELL CONSTRUCTION PERMIT#: Jerry Wilson

030376

N.C. Dept. of ENR


1. WELL USE (Check Applicable Box): Residential Municipal Industrial Agricultural Monitoring
 Recovery Heat Pump Water Injection Other If Other, List Use: _____

Winston-Salem Regional Office

2. WELL LOCATION: (Show sketch of the location below)
 Nearest Town: BLOWING ROCK County: WATAUGA
OFF BROWNSTONE RIDGE RD OFF GEORGE HAYES RD
(Road Name and Numbers, Community, or Subdivision and Lot No.)

4. DATE DRILLED 4/29/2004
 5. TOTAL DEPTH 665
 6. CUTTINGS COLLECTED YES NO
 7. DOES WELL REPLACE EXISTING WELL? YES NO
 8. STATIC WATER LEVEL Below Top of Casing: 200 FT.
(Use "+" if Above Top of Casing)
 9. TOP OF CASING IS 1 FT. Above Land Surface*
*Top of casing terminated at/or below land surface requires a variance in accordance with 15A NCAC 2C.0118
 10. YIELD (gpm): 0 METHOD OF TEST Air
 11. WATER ZONES (depth): 0.00 gpm 440-442 0.00 gpm
0.00 gpm 0.00 gpm
 12. CHLORINATION: Type HTH Amount 94


DRILLING LOG		DEPTH
From	To	Formation Description
0	5	DIRT SHALE GRANITE
5	440	GRANITE QUARTZ
440	442	GRANITE
442	665	GRANITE

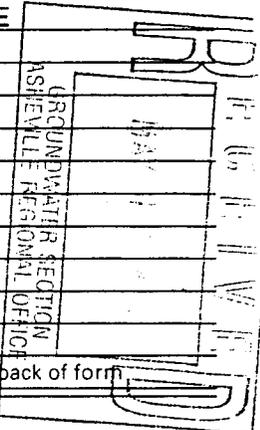

13. CASING:

From	Depth	To	Diameter	Wall Thickness or Weight/Ft.	Material
0		21 Ft.	6 1/8	.350	PVC
From		To			
From		To			

LOCATION SKETCH
 (Show direction and distance from at least two State Roads, or other map reference points)

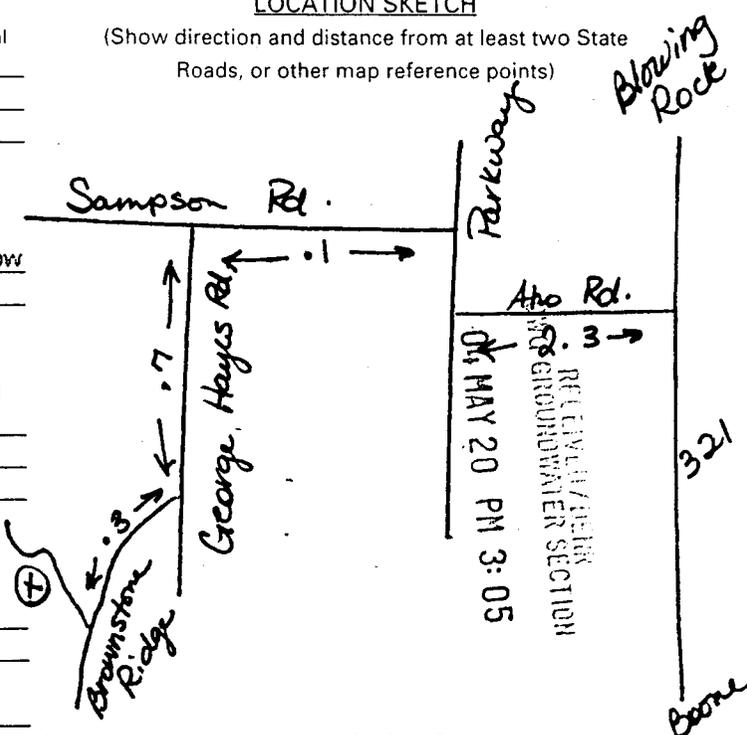

14. GROUT:

From	Depth	To	Material	Method
0		20 Ft.	Cement	Gravity Flow
From		To		

15. SCREEN:

From	Depth	To	Diameter	Slot Size	Material
From		To			
From		To			
From		To			

16. SAND/GRAVEL PACK:

From	Depth	To	Size	Material
From		To		
From		To		

17. REMARKS:
 I DO HEREBY CERTIFY THAT THIS WELL WAS CONSTRUCTED IN ACCORDANCE WITH 15A NCAC 2C, WELL CONSTRUCTION STANDARDS, AND THAT A COPY OF THIS RECORD HAS BEEN PROVIDED TO THE WELL OWNER.

Mary Wilson 5-14-2004
 SIGNATURE OF PERSON CONSTRUCTING THE WELL DATE

FOR OFFICE USE ONLY
 Quad No: _____
 Serial No. _____