

300840

**WELL CONSTRUCTION RECORD**

WELL CONTRACTOR: Dewey Wright Well Pump Co., Inc.

040378

WELL CONTRACTOR CERTIFICATION #: 2681

STATE WELL CONSTRUCTION PERMIT#: Steve Petty

1. WELL USE (Check Applicable Box): Residential  Municipal  Industrial  Agricultural  Monitoring   
 Recovery  Heat Pump Water Injection  Other  If Other, List Use: \_\_\_\_\_

2. WELL LOCATION: (Show sketch of the location below)

Nearest Town: DEEP GAP County: WATAUGA

MT PARON RD. OFF WILDCAT RD. OFF OLD 421 OFF H  
(Road Name and Numbers, Community, or Subdivision and Lot No.)

**DRILLING LOG**

**DEPTH**

From	To	Formation Description
0	65	DIRT
65	88	GRANITE
88	87	SHALE
87	130	GRANITE
130	132	SHALE
132	260	GRANITE
260	261	SHALE
261	305	GRANITE

4. DATE DRILLED 7/23/2004

5. TOTAL DEPTH 305

6. CUTTINGS COLLECTED YES  NO

7. DOES WELL REPLACE EXISTING WELL? YES  NO

8. STATIC WATER LEVEL Below Top of Casing: 20 FT.  
(Use "+" if Above Top of Casing)

9. TOP OF CASING IS 1 FT. Above Land Surface\*

\*Top of casing terminated at/or below land surface requires a variance in accordance with 15A NCAC 2C.0118

10. YIELD (gpm): 3 METHOD OF TEST Air

11. WATER ZONES (depth): 1.00 gpm 86-87 1.00 gpm 130-132

1.00 gpm 260-261 0.00 gpm


12. CHLORINATION: Type HTH Amount 57

If additional space is needed use back of form

13. CASING:

From	To	Depth	Diameter	Wall Thickness or Weight/Ft.	Material
0	70	Ft.	6 1/8	350	PVC
70	305	Ft.			

**LOCATION SKETCH**

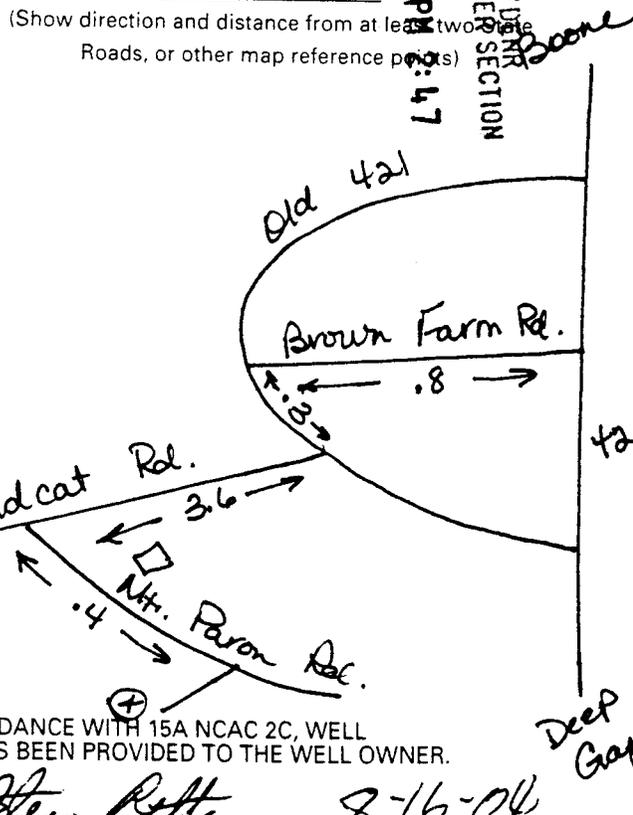

14. GROUT:

From	To	Depth	Material	Method
0	20	Ft.	Cement	Gravity Flow
20	305	Ft.		

15. SCREEN:

From	To	Depth	Diameter	Slot Size	Material
		Ft.	in.	in.	
		Ft.	in.	in.	
		Ft.	in.	in.	

16. SAND/GRAVEL PACK:

From	To	Depth	Size	Material
		Ft.		
		Ft.		

17. REMARKS:

I DO HEREBY CERTIFY THAT THIS WELL WAS CONSTRUCTED IN ACCORDANCE WITH 15A NCAC 2C, WELL CONSTRUCTION STANDARDS, AND THAT A COPY OF THIS RECORD HAS BEEN PROVIDED TO THE WELL OWNER.

**FOR OFFICE USE ONLY**

Quad No: \_\_\_\_\_

Serial No. \_\_\_\_\_

SIGNATURE OF PERSON CONSTRUCTING THE WELL  
 Submit original to Division of Water Quality, Groundwater Section within 30 days

DATE