

300854

WELL CONSTRUCTION RECORD

WELL CONTRACTOR: Dewey Wright Well Pump Co., Inc.
 WELL CONTRACTOR CERTIFICATION #: 2687
 STATE WELL CONSTRUCTION PERMIT#: Steve Reese

040229

1. WELL USE (Check Applicable Box): Residential Municipal Industrial Agricultural Monitoring
 Recovery Heat Pump Water Injection Other If Other, List Use: _____

2. WELL LOCATION: (Show sketch of the location below)

Nearest Town: BOONE County: WATAUGA

(Road Name and Numbers, Community, or Subdivision and Lot No.)

DRILLING LOG

From	To	DEPTH Formation Description
0	135	DIRT
135	200	GRANITE
200	203	SHALE
203	260	GRANITE

4. DATE DRILLED 7/14/2004
 5. TOTAL DEPTH 260
 6. CUTTINGS COLLECTED YES NO
 7. DOES WELL REPLACE EXISTING WELL? YES NO
 8. STATIC WATER LEVEL Below Top of Casing: 40 FT.
(Use "+" if Above Top of Casing)
 9. TOP OF CASING IS _____ FT. Above Land Surface*
*Top of casing terminated at/or below land surface requires a variance in accordance with 15A NCAC 2C.0118
 10. YIELD (gpm): 2 METHOD OF TEST Air
 11. WATER ZONES (depth): 2-00 gpm 200-203 0-00 gpm
0-00 gpm 0-00 gpm
 12. CHLORINATION: Type HTH Amount 45


RECEIVED/DEFER SECTION
 DIVISION OF GROUNDWATER
 04 AUG 24 PM 2:47

If additional space is needed use back of form

13. CASING:

From	To	Depth	Diameter	Wall Thickness or Weight/Ft.	Material
0	140	Ft.	5 1/8	180	GALV
140	260	Ft.			

LOCATION SKETCH

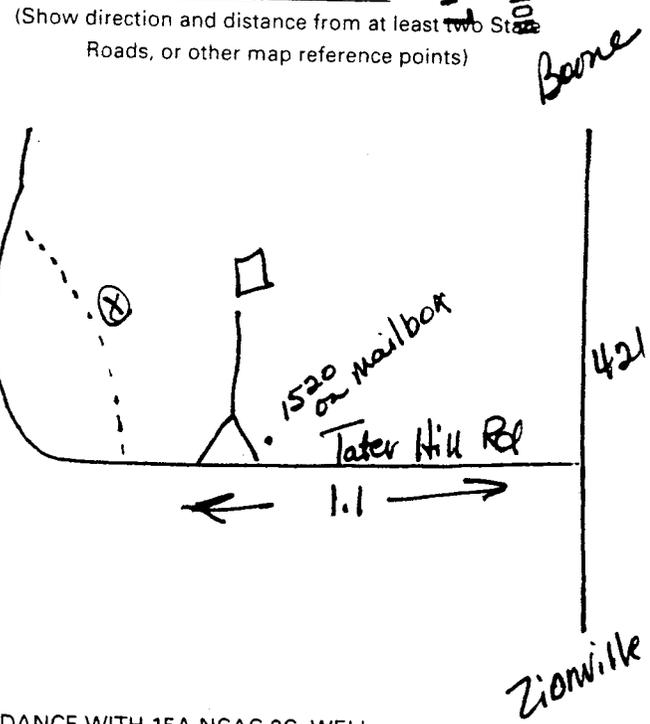

14. GROUT:

From	To	Depth	Material	Method
0	60	Ft.	Cement	Gravity Flow

15. SCREEN:

From	To	Depth	Diameter	Slot Size	Material
		Ft.	in.	in.	

16. SAND/GRAVEL PACK:

From	To	Depth	Size	Material
		Ft.		

17. REMARKS: _____

I DO HEREBY CERTIFY THAT THIS WELL WAS CONSTRUCTED IN ACCORDANCE WITH 15A NCAC 2C, WELL CONSTRUCTION STANDARDS, AND THAT A COPY OF THIS RECORD HAS BEEN PROVIDED TO THE WELL OWNER.

Steve Reese 8-13-04

SIGNATURE OF PERSON CONSTRUCTING THE WELL DATE
 Submit original to Division of Water Quality, Groundwater Section within 30 days

FOR OFFICE USE ONLY
 Quad No: _____
 Serial No: _____