

300855

**WELL CONSTRUCTION RECORD**

WELL CONTRACTOR: Dewey Wright Well Pump Co., Inc.  
 WELL CONTRACTOR CERTIFICATION #: 2687  
 STATE WELL CONSTRUCTION PERMIT#: Steve Reese

040362

1. WELL USE (Check Applicable Box): Residential  Municipal  Industrial  Agricultural  Monitoring   
 Recovery  Heat Pump Water Injection  Other  If Other, List Use: \_\_\_\_\_

2. WELL LOCATION: (Show sketch of the location below)  
 Nearest Town: BOONE County: WATAUGA  
TATER HILL RD OFF HWY 421  
(Road Name and Numbers, Community, or Subdivision and Lot No.)

DRILLING LOG		DEPTH
From	To	Formation Description
0	115	DIRT
115	121	GRANITE
121	122	QUARTZ
122	200	GRANITE
200	203	QUARTZ
203	240	GRANITE

4. DATE DRILLED 7/15/2004  
 5. TOTAL DEPTH 240  
 6. CUTTINGS COLLECTED YES  NO   
 7. DOES WELL REPLACE EXISTING WELL? YES  NO   
 8. STATIC WATER LEVEL Below Top of Casing: 40 FT.  
(Use "+" if Above Top of Casing)

9. TOP OF CASING IS 1 FT. Above Land Surface\*  
\*Top of casing terminated at/or below land surface requires a variance in accordance with 15A NCAC 2C.0118

10. YIELD (gpm): 50 METHOD OF TEST Air  
 11. WATER ZONES (depth): 45.00 gpm 121-122 5.00 gpm 200-203  
0.00 gpm 0.00 gpm

12. CHLORINATION: Type HTH Amount 41

13. CASING:

From	To	Depth	Diameter	Wall Thickness or Weight/Ft.	Material
0	120	Ft.	6 1/4"	1.00	Galv
120	240	Ft.			

14. GROUT:

From	To	Depth	Material	Method
0	20	Ft.	Cement	Gravity Flow
20	240	Ft.		

15. SCREEN:


From	To	Depth	Diameter	Slot Size	Material
		Ft.	in.	in.	
		Ft.	in.	in.	
		Ft.	in.	in.	

16. SAND/GRAVEL PACK:

From	To	Depth	Size	Material
		Ft.		
		Ft.		

17. REMARKS: \_\_\_\_\_

**LOCATION SKETCH**

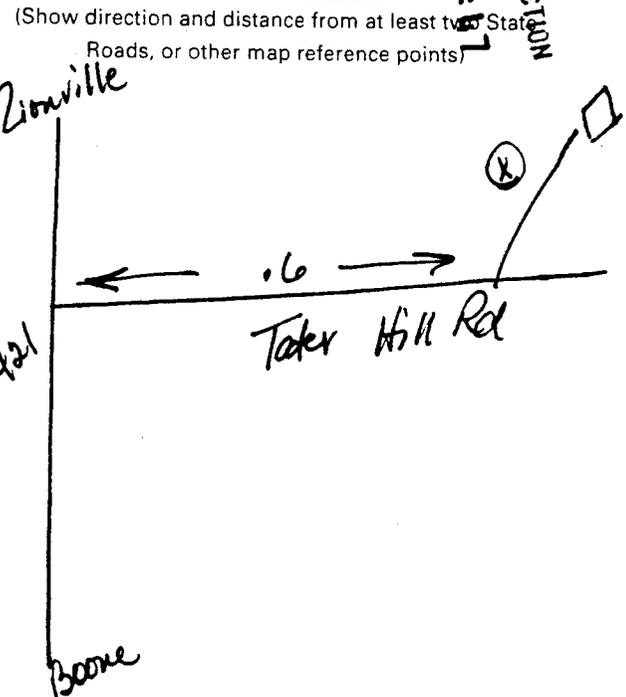

I DO HEREBY CERTIFY THAT THIS WELL WAS CONSTRUCTED IN ACCORDANCE WITH 15A NCAC 2C, WELL CONSTRUCTION STANDARDS, AND THAT A COPY OF THIS RECORD HAS BEEN PROVIDED TO THE WELL OWNER.

Steve Reese 8-13-04

SIGNATURE OF PERSON CONSTRUCTING THE WELL DATE  
 Submit original to Division of Water Quality, Groundwater Section within 30 days

**FOR OFFICE USE ONLY**  
 Quad No: \_\_\_\_\_  
 Serial No. \_\_\_\_\_