

300857

WELL CONSTRUCTION RECORD

WELL CONTRACTOR: Dewey Wright Well Pump Co. Inc.
 WELL CONTRACTOR CERTIFICATION #: 2687
 STATE WELL CONSTRUCTION PERMIT #: Steve Reece

040297-2

1. WELL USE (Check Applicable Box): Residential Municipal Industrial Agricultural Monitoring
 Recovery Heat Pump Water Injection Other If Other, List Use: _____

2. WELL LOCATION: (Show sketch of the location below)
 Nearest Town: BOONE County: WATAUGA
Shadowline Dr. Off 321
(Road Name and Numbers, Community, or Subdivision and Lot No.)

DRILLING LOG		DEPTH
From	To	Formation Description
0	45	DIRT
45	200	GRANITE
200	203	QUARTZ
203	515	GRANITE
515	519	QUARTZ
519	530	GRANITE

4. DATE DRILLED 7/6 2004
 5. TOTAL DEPTH 530
 6. CUTTINGS COLLECTED YES NO
 7. DOES WELL REPLACE EXISTING WELL? YES NO
 8. STATIC WATER LEVEL Below Top of Casing: 30 FT.
(Use "+" if Above Top of Casing)

9. TOP OF CASING IS 1 FT. Above Land Surface*
*Top of casing terminated at/or below land surface requires a variance in accordance with 15A NCAC 2C.0118

10. YIELD (gpm): 100 METHOD OF TEST Air

11. WATER ZONES (depth): 0.00 gpm 200-203 04.00 gpm 515-519
0.00 gpm 0.00 gpm

12. CHLORINATION: Type HTH Amount 50

13. CASING:

From	To	Depth	Diameter	Wall Thickness or Weight/Ft.	Material
0	65	Ft.	6 1/8	350	PVC
65		Ft.			
		Ft.			

14. GROUT:

From	To	Depth	Material	Method
0	30	Ft.	Cement	Gravity Flow
		Ft.		


15. SCREEN:

From	To	Depth	Diameter	Slot Size	Material
		Ft.	in.	in.	
		Ft.	in.	in.	
		Ft.	in.	in.	

16. SAND/GRAVEL PACK:

From	To	Depth	Size	Material
		Ft.		
		Ft.		

17. REMARKS: _____

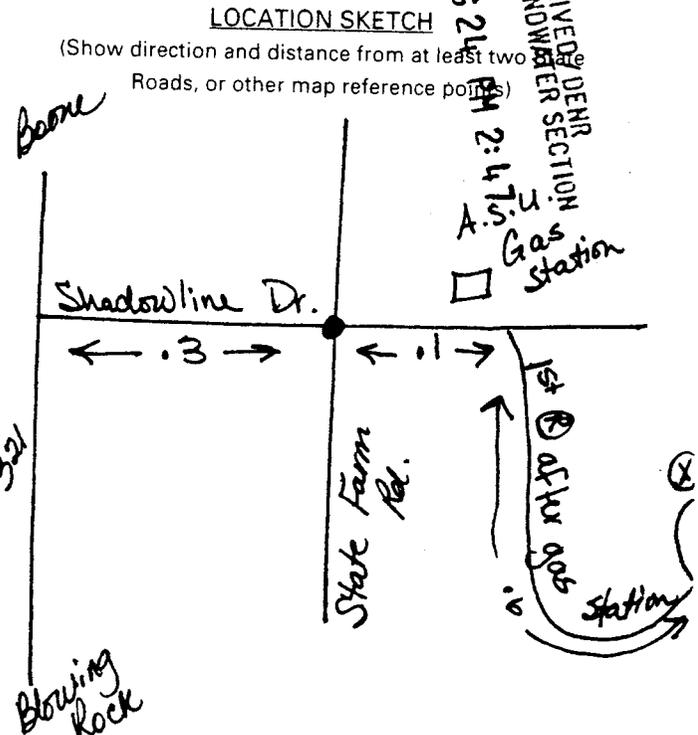

RECEIVED DENR SECTION
 DIVISION OF GROUNDWATER
 AUG 24 PM 2:47:54

I DO HEREBY CERTIFY THAT THIS WELL WAS CONSTRUCTED IN ACCORDANCE WITH 15A NCAC 2C, WELL CONSTRUCTION STANDARDS, AND THAT A COPY OF THIS RECORD HAS BEEN PROVIDED TO THE WELL OWNER.

Steve Reece 8-13-04

SIGNATURE OF PERSON CONSTRUCTING THE WELL DATE
 Submit original to Division of Water Quality, Groundwater Section within 30 days

FOR OFFICE USE ONLY

Quad No: _____

Serial No. _____