

300860

# WELL CONSTRUCTION RECORD

WELL CONTRACTOR: Dewey Wright Well Pump Co. Inc.  
 WELL CONTRACTOR CERTIFICATION #: 2687  
 STATE WELL CONSTRUCTION PERMIT#: Steve Reece

040350

1. WELL USE (Check Applicable Box): Residential  Municipal  Industrial  Agricultural  Monitoring   
 Recovery  Heat Pump Water Injection  Other  If Other, List Use: \_\_\_\_\_

2. WELL LOCATION: (Show sketch of the location below)

Nearest Town: BOONE County: WATAUGA  
PRIVATE DR OFF ELK CREEK RD OFF OLD HWY 421  
(Road Name and Numbers, Community, or Subdivision and Lot No.)

DRILLING LOG		DEPTH
From	To	Formation Description
0	20	DIRT
20	30	GRANITE
30	32	SHALE
32	40	GRANITE
40	43	SHALE
43	120	GRANITE

If additional space is needed use back of form

4. DATE DRILLED 7/22/2004  
 5. TOTAL DEPTH 120  
 6. CUTTINGS COLLECTED YES  NO   
 7. DOES WELL REPLACE EXISTING WELL? YES  NO   
 8. STATIC WATER LEVEL Below Top of Casing: 20 FT.  
(Use "+" if Above Top of Casing)  
 9. TOP OF CASING IS 1 FT. Above Land Surface\*  
\*Top of casing terminated at/or below land surface requires a variance in accordance with 15A NCAC 2C.0118  
 10. YIELD (gpm): 5 METHOD OF TEST Air  
 11. WATER ZONES (depth): 2.00 gpm 30-32 3.00 gpm 40-43  
0.00 gpm 0.00 gpm  
 12. CHLORINATION: Type HTH Amount 21

13. CASING:

From	To	Depth	Diameter	Wall Thickness or Weight/Ft.	Material
0	27	Ft.	6 1/8	350	PVC

14. GROUT:

From	To	Depth	Material	Method
0	20	Ft.	Cement	Gravity Flow

15. SCREEN:


From	To	Depth	Diameter	Slot Size	Material

16. SAND/GRAVEL PACK:

From	To	Depth	Size	Material

17. REMARKS:

I DO HEREBY CERTIFY THAT THIS WELL WAS CONSTRUCTED IN ACCORDANCE WITH 15A NCAC 2C, WELL CONSTRUCTION STANDARDS, AND THAT A COPY OF THIS RECORD HAS BEEN PROVIDED TO THE WELL OWNER.

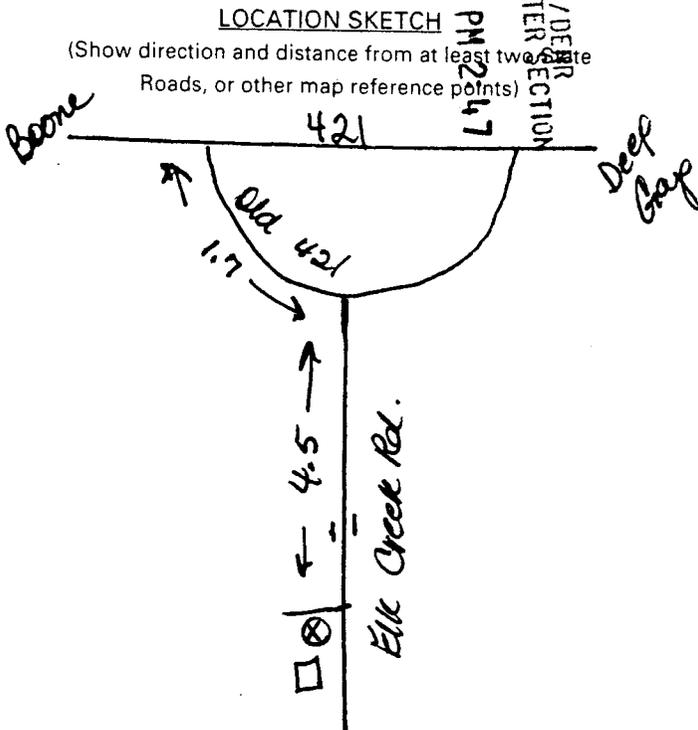

**FOR OFFICE USE ONLY**

Quad No: \_\_\_\_\_

Serial No. \_\_\_\_\_

Steve Reece 8-13-04  
 SIGNATURE OF PERSON CONSTRUCTING THE WELL DATE  
 Submit original to Division of Water Quality, Groundwater Section within 30 days