

300861

**WELL CONSTRUCTION RECORD**

WELL CONTRACTOR: Dewey Wright Well Pump Co., Inc  
 WELL CONTRACTOR CERTIFICATION #: 2878  
 STATE WELL CONSTRUCTION PERMIT#: Steve Price

040347

1. WELL USE (Check Applicable Box): Residential  Municipal  Industrial  Agricultural  Monitoring   
 Recovery  Heat Pump Water Injection  Other  If Other, List Use: \_\_\_\_\_

2. WELL LOCATION: (Show sketch of the location below)  
 Nearest Town: BOONE County: WATAUGA  
PRIVATE DR. OFF BEAVER DAM RD. OFF BETHEL RD.  
(Road Name and Numbers, Community, or Subdivision and Lot No.)

DRILLING LOG		DEPTH
From	To	Formation Description
0	29	DIRT
29	450	GRANITE
450	451	GRANITE
451	470	GRANITE
470	471	GRANITE
471	505	GRANITE

4. DATE DRILLED 7/16/2004  
 5. TOTAL DEPTH 505  
 6. CUTTINGS COLLECTED YES  NO   
 7. DOES WELL REPLACE EXISTING WELL? YES  NO   
 8. STATIC WATER LEVEL Below Top of Casing: 50 FT.  
(Use "+" if Above Top of Casing)

9. TOP OF CASING IS 1 FT. Above Land Surface\*  
\*Top of casing terminated at/or below land surface requires a variance in accordance with 15A NCAC 2C.0118


10. YIELD (gpm): 1 METHOD OF TEST Air  
 11. WATER ZONES (depth): 0-50 gpm 450-451 0-50 gpm 470-471  
0.00 gpm 0.00 gpm

12. CHLORINATION: Type HTH Amount 92

13. CASING:

From	To	Depth	Diameter	Wall Thickness or Weight/Ft.	Material
0	35	Ft.	8 1/8	.350	PVC
35	505	Ft.			

LOCATION SKETCH  
Show direction and distance from at least two roads, or other map reference points)

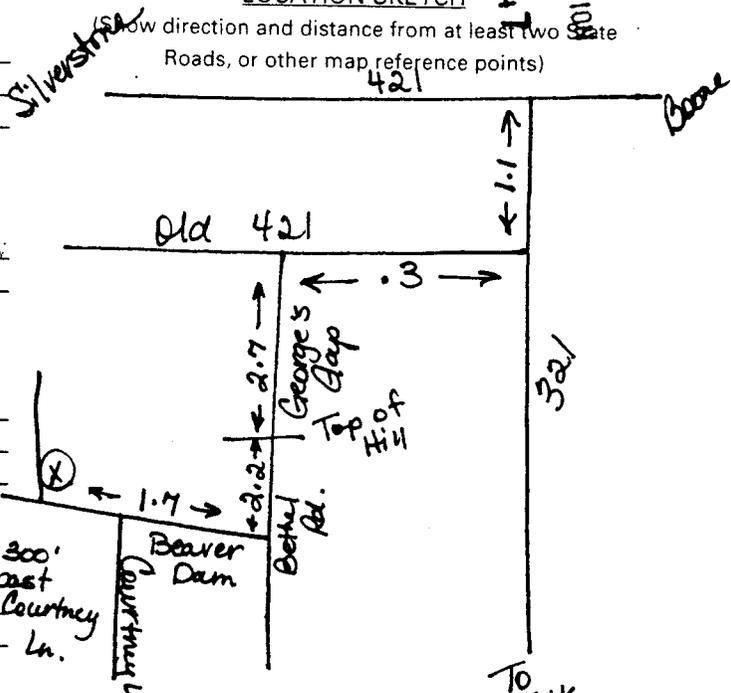

14. GROUT:

From	To	Depth	Material	Method
0	20	Ft.	Cement	Gravity Flow
20	505	Ft.		

15. SCREEN:

From	To	Depth	Diameter	Slot Size	Material
		Ft.	in.	in.	

16. SAND/GRAVEL PACK:

From	To	Depth	Size	Material
		Ft.		

17. REMARKS: \_\_\_\_\_  
 I DO HEREBY CERTIFY THAT THIS WELL WAS CONSTRUCTED IN ACCORDANCE WITH 15A NCAC 2C, WELL CONSTRUCTION STANDARDS, AND THAT A COPY OF THIS RECORD HAS BEEN PROVIDED TO THE WELL OWNER.

FOR OFFICE USE ONLY  
 Quad No: \_\_\_\_\_  
 Serial No. \_\_\_\_\_

Steve Price  
 SIGNATURE OF PERSON CONSTRUCTING THE WELL  
 DATE 8-13-09  
 Submit original to Division of Water Quality, Groundwater Section within 30 days