

300865

WELL CONSTRUCTION RECORD

WELL CONTRACTOR: Dewey Wright Well Pump Co., Inc.
 WELL CONTRACTOR CERTIFICATION #: 2878
 STATE WELL CONSTRUCTION PERMIT#: Steve Price

030262

1. WELL USE (Check Applicable Box): Residential Municipal Industrial Agricultural Monitoring
 Recovery Heat Pump Water Injection Other If Other, List Use: _____

2. WELL LOCATION: (Show sketch of the location below)
 Nearest Town: BOONE County: WATAUGA
WATER FALLS RD OFF FAUN'S NEST OFF FAUN DR. C
(Road Name and Numbers, Community, or Subdivision and Lot No.)


DRILLING LOG		DEPTH
From	To	Formation Description
0	31	DIRT
31	315	GRANITE
315	316	GRANITE
316	350	GRANITE
350	351	QUARTZ
351	390	GRANITE
390	391	QUARTZ
391	405	GRANITE

4. DATE DRILLED 7/2/2003
 5. TOTAL DEPTH 405
 6. CUTTINGS COLLECTED YES NO
 7. DOES WELL REPLACE EXISTING WELL? YES NO
 8. STATIC WATER LEVEL Below Top of Casing: 33 FT.
(Use "+" if Above Top of Casing)
 9. TOP OF CASING IS 1 FT. Above Land Surface*
*Top of casing terminated at/or below land surface requires a variance in accordance with 15A NCAC 2C.0118
 10. YIELD (gpm): 2 METHOD OF TEST Air
 11. WATER ZONES (depth): 0.50 gpm 315-316 0.50 gpm 350-351
3.00 gpm 390-391 0.20 gpm
 12. CHLORINATION: Type HTH Amount 74

13. CASING:

From	To	Depth	Diameter	Wall Thickness or Weight/Ft.	Material
0	37	Ft.	8 1/8	350	PVC
37	405	Ft.			

LOCATION SKETCH
 (Show direction and distance from at least two state roads, or other map reference points)

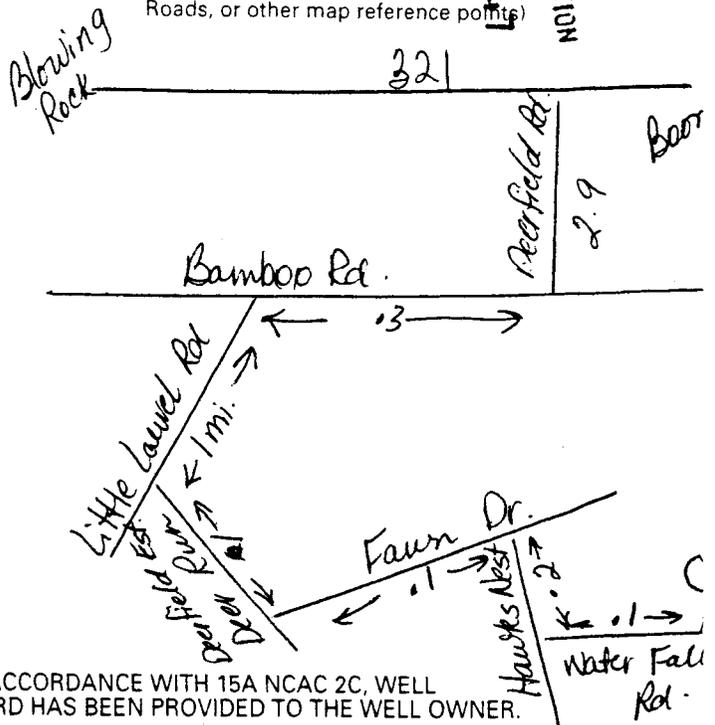

14. GROUT:

From	To	Depth	Material	Method
0	20	Ft.	Cement	Gravity Flow
20	405	Ft.		

15. SCREEN:

From	To	Depth	Diameter	Slot Size	Material
		Ft.	in.	in.	
		Ft.	in.	in.	
		Ft.	in.	in.	

16. SAND/GRAVEL PACK:

From	To	Depth	Size	Material
		Ft.		
		Ft.		

17. REMARKS: _____

I DO HEREBY CERTIFY THAT THIS WELL WAS CONSTRUCTED IN ACCORDANCE WITH 15A NCAC 2C, WELL CONSTRUCTION STANDARDS, AND THAT A COPY OF THIS RECORD HAS BEEN PROVIDED TO THE WELL OWNER.

FOR OFFICE USE ONLY
 Quad No: _____
 Serial No. _____

Steve Price
 SIGNATURE OF PERSON CONSTRUCTING THE WELL
 DATE 8-13-04
 Submit original to Division of Water Quality, Groundwater Section within 30 days