

302182

WELL CONSTRUCTION RECORD

WELL CONTRACTOR: Dewey Wright Well Pump Co., Inc.
 WELL CONTRACTOR CERTIFICATION #: 2878
 STATE WELL CONSTRUCTION PERMIT#: Steve Price

040284

1. WELL USE (Check Applicable Box): Residential Municipal Industrial Agricultural Monitoring
 Recovery Heat Pump Water Injection Other If Other, List Use: _____

2. WELL LOCATION: (Show sketch of the location below)
 Nearest Town: BOONE County: WATAUGA
OLD HAMPTON RD.
(Road Name and Numbers, Community, or Subdivision and Lot No.)

RECEIVED
 N.C. DEPT. OF ENVR
 OCT 15 2004

DRILLING LOG		DEPTH	Formation Description
From	To		
0	36		DIRT
36	400		GRANITE
400	401		GRANITE
401	510		GRANITE
510	511		QUARTZ
511	525		GRANITE

RECEIVED DIVISION OF WATER QUALITY
 04 SEP 24 04 11:15 PM

4. DATE DRILLED 8/16/2004
 5. TOTAL DEPTH 525
 6. CUTTINGS COLLECTED YES NO
 7. DOES WELL REPLACE EXISTING WELL? YES NO
 8. STATIC WATER LEVEL Below Top of Casing: 150 FT.
(Use "*" if Above Top of Casing)
 9. TOP OF CASING IS 1 FT. Above Land Surface*
*Top of casing terminated at/or below land surface requires a variance in accordance with 15A NCAC 2C.0118
 10. YIELD (gpm): 2.5 METHOD OF TEST Air
 11. WATER ZONES (depth): 0.50 gpm 400-401 2.00 gpm 510-511
0.00 gpm 0.00 gpm
 12. CHLORINATION: Type HTH Amount 74

13. CASING:

From	To	Depth	Diameter	Wall Thickness or Weight/Ft.	Material
0	42	Ft.	6 1/8	.350	PVC
42	525	Ft.			

LOCATION SKETCH
 (Show direction and distance from at least two State Roads, or other map reference points)

14. GROUT:

From	To	Depth	Material	Method
0	20	Ft.	Cement	Gravity Flow
20	525	Ft.		


15. SCREEN:

From	To	Depth	Diameter	Slot Size	Material
		Ft.	in.	in.	
		Ft.	in.	in.	
		Ft.	in.	in.	

16. SAND/GRAVEL PACK:

From	To	Depth	Size	Material
		Ft.		
		Ft.		

17. REMARKS: _____

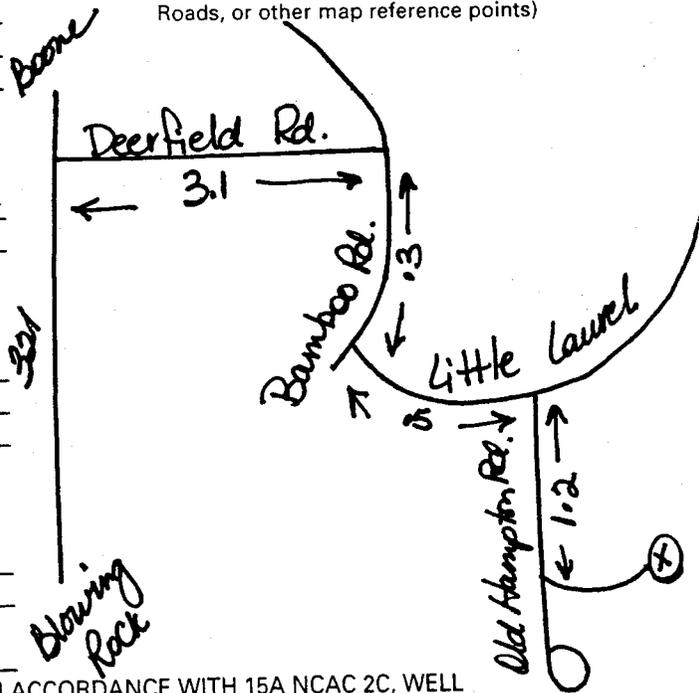

FOR OFFICE USE ONLY
 Quad No: _____
 Serial No. _____

Steven Price
 SIGNATURE OF PERSON CONSTRUCTING THE WELL
 Submit original to Division of Water Quality, Groundwater Section within 30 days

9-16-04
 DATE
 GW-1 REV. 12/99