

302195

WELL CONSTRUCTION RECORD

WELL CONTRACTOR: Dewey Wright Well Pump Co., Inc.
 WELL CONTRACTOR CERTIFICATION #: 2681
 STATE WELL CONSTRUCTION PERMIT#: Steve Petty

040376

1. WELL USE (Check Applicable Box): Residential Municipal Industrial Agricultural Monitoring
 Recovery Heat Pump Water Injection Other If Other, List Use: RECEIVED
 N.C. Dept. of EHNR

2. WELL LOCATION: (Show sketch of the location below)
 Nearest Town: BANNER ELK County: WATAUGA
ROMINGER RD. OFF 194 OFF BROADSTONE RD. OFF 10
(Road Name and Numbers, Community, or Subdivision and Lot No.)

OCT 15 2004

DRILLING LOG

From	To	Formation Description
0	25	DIRT
25	53	GRANITE
53	54	SHALE
54	87	GRANITE
87	89	SHALE
89	115	GRANITE
115	117	SHALE
117	125	GRANITE


4. DATE DRILLED 8/17/2004
 5. TOTAL DEPTH 125
 6. CUTTINGS COLLECTED YES NO
 7. DOES WELL REPLACE EXISTING WELL? YES NO
 8. STATIC WATER LEVEL Below Top of Casing: 20 FT.
(Use "+" if Above Top of Casing)

9. TOP OF CASING IS 1 FT. Above Land Surface*
*Top of casing terminated at/or below land surface requires a variance in accordance with 15A NCAC 2C.0118
 10. YIELD (gpm): 60 METHOD OF TEST: Air
 11. WATER ZONES (depth): 5.00 gpm 53-54 15.00 gpm 87-89
40.00 gpm 115-117 0.00 gpm
 12. CHLORINATION: Type HTH Amount 22

If additional space is needed use back of form

LOCATION SKETCH

(Show direction and distance from at least two State Roads, or other map reference points)

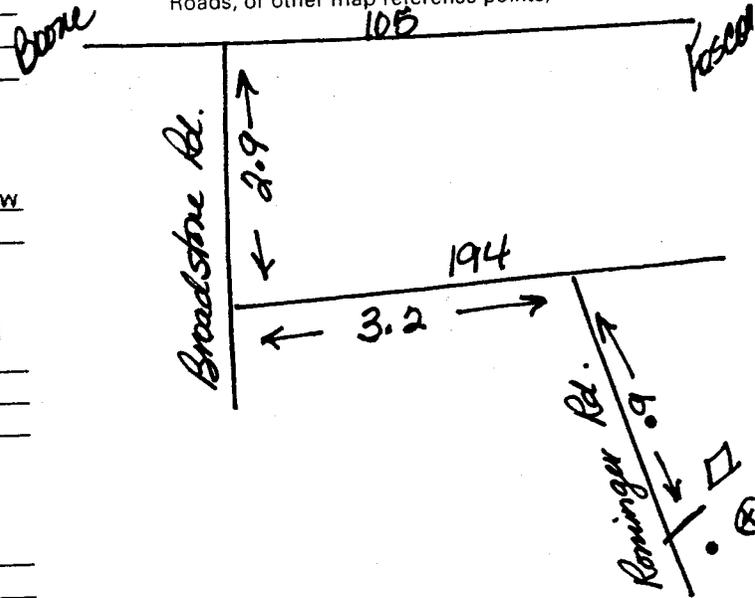

13. CASING:
 From 0 To 31 Ft. Diameter 6 1/8 Wall Thickness or Weight/Ft. 350 Material PVC
 From _____ To _____ Ft. _____
 From _____ To _____ Ft. _____

14. GROUT:
 From 0 To 20 Ft. Material Cement Method Gravity Flow
 From _____ To _____ Ft. _____

15. SCREEN:
 From _____ To _____ Ft. Diameter _____ Slot Size _____ Material _____
 From _____ To _____ Ft. _____
 From _____ To _____ Ft. _____

16. SAND/GRAVEL PACK:
 From _____ To _____ Ft. Size _____ Material _____
 From _____ To _____ Ft. _____

17. REMARKS: _____
 I DO HEREBY CERTIFY THAT THIS WELL WAS CONSTRUCTED IN ACCORDANCE WITH 15A NCAC 2C, WELL CONSTRUCTION STANDARDS, AND THAT A COPY OF THIS RECORD HAS BEEN PROVIDED TO THE WELL OWNER.

Steve Petty DATE 9-15-04

SIGNATURE OF PERSON CONSTRUCTING THE WELL
 Submit original to Division of Water Quality, Groundwater Section within 30 days

FOR OFFICE USE ONLY
 Quad No: _____
 Serial No. _____