

304178

**WELL CONSTRUCTION RECORD**

040384

WELL CONTRACTOR: Dewey Wright Well Pump Co., Inc.  
 WELL CONTRACTOR CERTIFICATION #: 2681  
 STATE WELL CONSTRUCTION PERMIT#: Steve Petty

1. WELL USE (Check Applicable Box): Residential  Municipal  Industrial  Agricultural  Monitoring   
 Recovery  Heat Pump Water Injection  Other  If Other, List Use: \_\_\_\_\_

NOV 23 2004

2. WELL LOCATION: (Show sketch of the location below)  
 Nearest Town: BOONE County: WATAUGA  
MAPLEWOOD CIRCLE OFF 105 BYPASS OFF 105  
(Road Name and Numbers, Community, or Subdivision and Lot No.)

Winston-Salem  
 Regional Office

**DRILLING LOG**

From	To	Formation Description
0	75	DIRT
75	100	GRANITE
100	101	SHALE
101	360	GRANITE
360	362	SHALE
362	385	GRANITE

4. DATE DRILLED 9/16/2004  
 5. TOTAL DEPTH 385  
 6. CUTTINGS COLLECTED YES  NO   
 7. DOES WELL REPLACE EXISTING WELL? YES  NO   
 8. STATIC WATER LEVEL Below Top of Casing: 100 FT.  
(Use "+" if Above Top of Casing)  
 9. TOP OF CASING IS 1 FT. Above Land Surface\*  
\*Top of casing terminated at/or below land surface requires a variance in accordance with 15A NCAC 2C.0118  
 10. YIELD (gpm): 0 METHOD OF TEST Air  
 11. WATER ZONES (depth): 1.00 gpm 100-101 5.00 gpm 360-362  
0.00 gpm 0.00 gpm  
 12. CHLORINATION: Type HTH Amount 57

If additional space is needed use back of form

13. CASING:  
 From 0 To 80 Ft. Depth 6 1/8 Diameter .350 Wall Thickness or Weight/Ft. PVC Material

14. GROUT:  
 From 0 To 20 Ft. Depth Cement Material Gravity Flow Method


15. SCREEN:  
 From \_\_\_\_\_ To \_\_\_\_\_ Ft. Depth \_\_\_\_\_ Diameter \_\_\_\_\_ Slot Size \_\_\_\_\_ Material \_\_\_\_\_

16. SAND/GRAVEL PACK:  
 From \_\_\_\_\_ To \_\_\_\_\_ Ft. Depth \_\_\_\_\_ Size \_\_\_\_\_ Material \_\_\_\_\_

17. REMARKS:  
 I DO HEREBY CERTIFY THAT THIS WELL WAS CONSTRUCTED IN ACCORDANCE WITH 15A NCAC 2C, WELL CONSTRUCTION STANDARDS, AND THAT A COPY OF THIS RECORD HAS BEEN PROVIDED TO THE WELL OWNER.

**LOCATION SKETCH**

(Show direction and distance from at least two State Roads, or other map reference points)

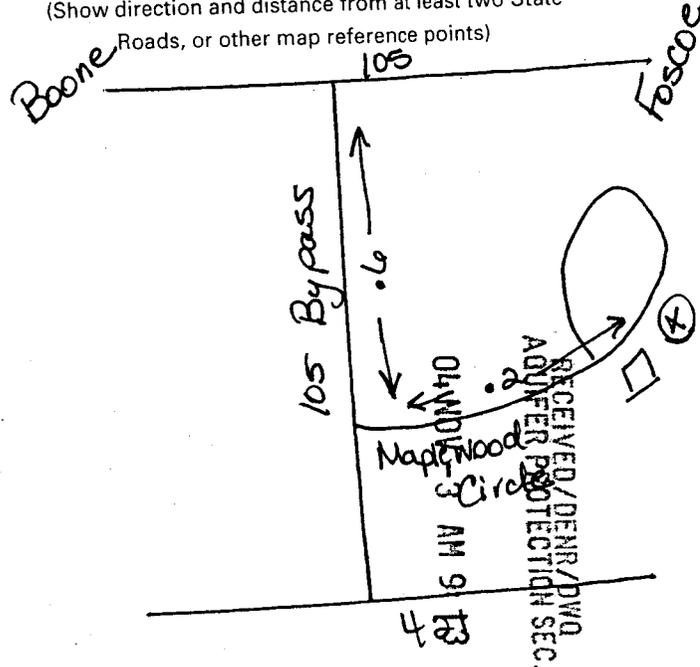

**FOR OFFICE USE ONLY**

Quad No: \_\_\_\_\_

SIGNATURE OF PERSON CONSTRUCTING THE WELL Steve Petty  
 Submit original to Division of Water Quality, Groundwater Section within 30 days

DATE

10-20-04