

304700

WELL CONSTRUCTION RECORD

040519

WELL CONTRACTOR: Dewey Wright Well Pump Co., Inc.
 WELL CONTRACTOR CERTIFICATION #: 2688
 STATE WELL CONSTRUCTION PERMIT#: Leslie Reece

1. WELL USE (Check Applicable Box): Residential Municipal Industrial Agricultural Monitoring
 Recovery Heat Pump Water Injection Other If Other, List Use: _____

2. WELL LOCATION: (Show sketch of the location below)
 Nearest Town: BOONE County: WATAUGA
MYRIA LANE OFF OLD TURNPIKE RD. OFF SHULL MILL
(Road Name and Numbers, Community, or Subdivision and Lot No.)

DRILLING LOG		DEPTH
From	To	Formation Description
0	40	DIRT
40	101	GRANITE
101	102	SHALE
102	375	GRANITE
375	376	SHALE
376	420	GRANITE

4. DATE DRILLED 10/15/2004
 5. TOTAL DEPTH 420
 6. CUTTINGS COLLECTED YES NO
 7. DOES WELL REPLACE EXISTING WELL? YES NO
 8. STATIC WATER LEVEL Below Top of Casing: 60 FT.
(Use "+" if Above Top of Casing)


9. TOP OF CASING IS 1 FT. Above Land Surface*
*Top of casing terminated at/or below land surface requires a variance in accordance with 15A NCAC 2C.0118

10. YIELD (gpm): 4 METHOD OF TEST Air
 11. WATER ZONES (depth): 0.50 gpm 101-102 3.50 gpm 375-376
0.00 gpm 0.00 gpm

12. CHLORINATION: Type HTH Amount 72

LOCATION SKETCH

(Show direction and distance from at least two State Roads, or other map reference points)

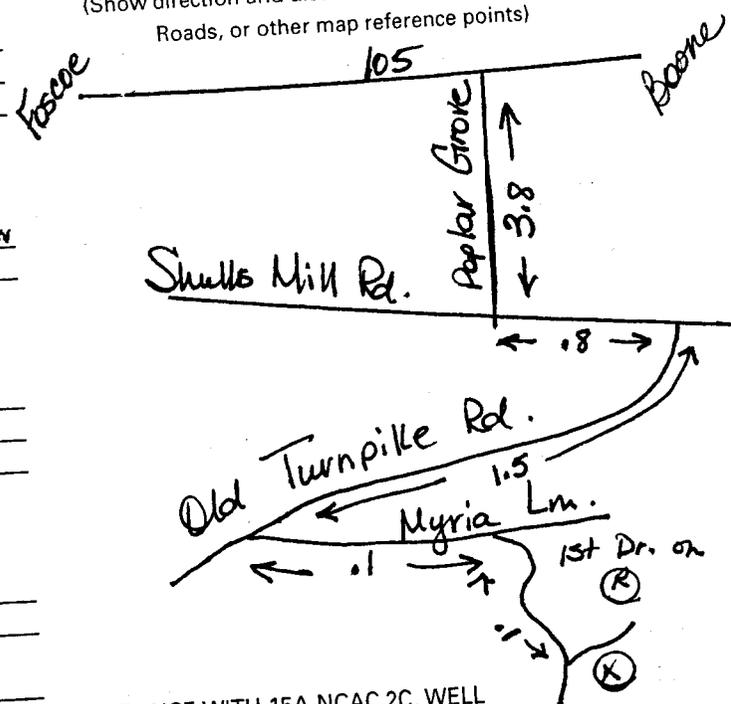

13. CASING:
 From 0 To 43 Ft. Diameter 6 1/8 Wall Thickness or Weight/Ft. .350 Material PVC
 From _____ To _____ Ft. _____
 From _____ To _____ Ft. _____

14. GROUT:
 From 0 To 20 Ft. Material Cement Method Gravity Flow
 From _____ To _____ Ft. _____

15. SCREEN:
 From _____ To _____ Ft. Diameter _____ in. Slot Size _____ in. Material _____
 From _____ To _____ Ft. _____ in. _____ in. _____
 From _____ To _____ Ft. _____ in. _____ in. _____

16. SAND/GRAVEL PACK:
 From _____ To _____ Ft. Size _____ Material _____
 From _____ To _____ Ft. _____

17. REMARKS: _____
 I DO HEREBY CERTIFY THAT THIS WELL WAS CONSTRUCTED IN ACCORDANCE WITH 15A NCAC 2C, WELL CONSTRUCTION STANDARDS, AND THAT A COPY OF THIS RECORD HAS BEEN PROVIDED TO THE WELL OWNER.

FOR OFFICE USE ONLY
 Quad No: _____

Wayne Reece
 SIGNATURE OF PERSON CONSTRUCTING THE WELL
 DATE 11-23-04
 Submit original to Division of Water Quality, Groundwater Section within 30 days
 GW-1 REV. 12/99