

304712

**WELL CONSTRUCTION RECORD**

040550

WELL CONTRACTOR: Dewey Wright Well Pump Co., Inc.  
 WELL CONTRACTOR CERTIFICATION #: 2887  
 STATE WELL CONSTRUCTION PERMIT#: Steve Reece

1. WELL USE (Check Applicable Box): Residential  Municipal  Industrial  Agricultural  Monitoring   
 Recovery  Heat Pump Water Injection  Other  If Other, List Use: \_\_\_\_\_

2. WELL LOCATION: (Show sketch of the location below)  
 Nearest Town: FOSCOE County: WATAUGA  
OLD TURNPIKE RD OFF SHULLS MILL RD. OFF OLD SH  
(Road Name and Numbers, Community, or Subdivision and Lot No.)

**DRILLING LOG**

From	To	DEPTH
0	38	DIRT ROCK
38	55	GRANITE
55	58	SHALE QUARTZ
58	120	GRANITE
120	124	QUARTZ
124	300	GRANITE

4. DATE DRILLED: 11/2/2004  
 5. TOTAL DEPTH: 300  
 6. CUTTINGS COLLECTED YES  NO   
 7. DOES WELL REPLACE EXISTING WELL? YES  NO   
 8. STATIC WATER LEVEL Below Top of Casing: 30 FT.  
(Use "+" if Above Top of Casing)

9. TOP OF CASING IS 1 FT. Above Land Surface\*  
\*Top of casing terminated at/or below land surface requires a variance in accordance with 15A NCAC 2C.0118

10. YIELD (gpm): 15.00 gpm 55-58 15.00 gpm 120-124  
 11. WATER ZONES (depth): 0.00 gpm 0.00 gpm

12. CHLORINATION: Type HTH Amount 55

13. CASING:  
 From 0 To 44 Ft. Diameter 6 1/8 Wall Thickness or Weight/Ft. .350 Material PVC  
 From \_\_\_\_\_ To \_\_\_\_\_ Ft. \_\_\_\_\_  
 From \_\_\_\_\_ To \_\_\_\_\_ Ft. \_\_\_\_\_

14. GROUT:  
 From 0 To 20 Ft. Material Cement Method Gravity Flow  
 From \_\_\_\_\_ To \_\_\_\_\_ Ft. \_\_\_\_\_

15. SCREEN:  
 From \_\_\_\_\_ To \_\_\_\_\_ Ft. Diameter \_\_\_\_\_ Slot Size \_\_\_\_\_ Material \_\_\_\_\_  
 From \_\_\_\_\_ To \_\_\_\_\_ Ft. \_\_\_\_\_  
 From \_\_\_\_\_ To \_\_\_\_\_ Ft. \_\_\_\_\_

16. SAND/GRAVEL PACK:  
 From \_\_\_\_\_ To \_\_\_\_\_ Ft. Size \_\_\_\_\_ Material \_\_\_\_\_  
 From \_\_\_\_\_ To \_\_\_\_\_ Ft. \_\_\_\_\_


17. REMARKS: \_\_\_\_\_  
 I DO HEREBY CERTIFY THAT THIS WELL WAS CONSTRUCTED IN ACCORDANCE WITH 15A NCAC 2C, WELL CONSTRUCTION STANDARDS, AND THAT A COPY OF THIS RECORD HAS BEEN PROVIDED TO THE WELL OWNER.

Steve Reece 11-17-04  
 SIGNATURE OF PERSON CONSTRUCTING THE WELL DATE

Submit original to Division of Water Quality, Groundwater Section within 30 days  
 GW-1 REV. 12/99

FOR OFFICE USE ONLY  
 Quad No: \_\_\_\_\_

LOCATION SKETCH  
 (Show direction and distance from at least two State Roads, or other map reference points)

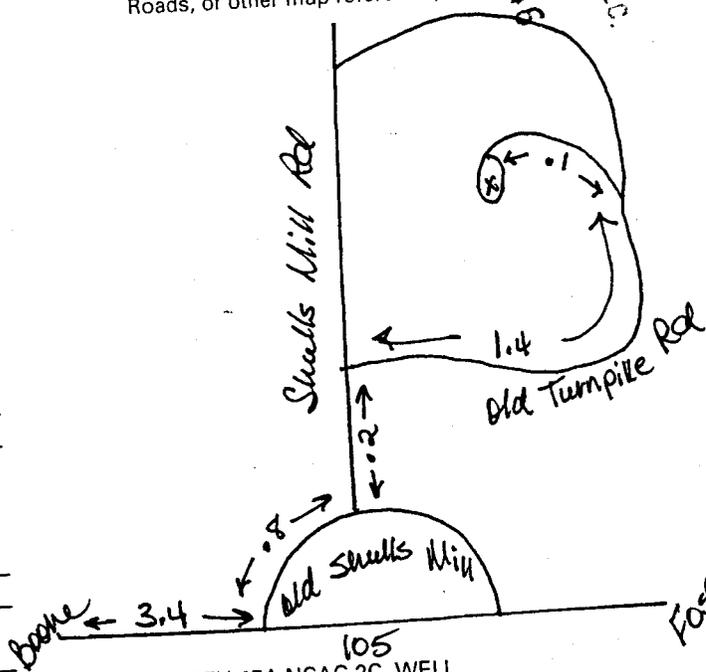

DIVISION OF WATER QUALITY  
 GROUNDWATER PROTECTION SECTION  
 PH 5:46