

304725

**WELL CONSTRUCTION RECORD**

WELL CONTRACTOR: Dewey Wright Well Pump Co., Inc.  
 WELL CONTRACTOR CERTIFICATION #: 2878  
 STATE WELL CONSTRUCTION PERMIT#: Steve Price

040466

1. WELL USE (Check Applicable Box): Residential  Municipal  Industrial  Agricultural  Monitoring   
 Recovery  Heat Pump Water Injection  Other  If Other, List Use: \_\_\_\_\_

2. WELL LOCATION: (Show sketch of the location below)  
 Nearest Town: BOONE County: WATAUGA  
HWY 321 OFF 421  
(Road Name and Numbers, Community, or Subdivision and Lot No.)

DRILLING LOG		DEPTH
From	To	Formation Description
0	64	DIRT
64	235	GRANITE
235	236	QUARTZ
236	248	GRANITE
248	249	RED GRANITE
249	255	GRANITE
255	256	QUARTZ
256	265	GRANITE

If additional space is needed use back of form

4. DATE DRILLED 10/11/2004  
 5. TOTAL DEPTH 265  
 6. CUTTINGS COLLECTED YES  NO   
 7. DOES WELL REPLACE EXISTING WELL? YES  NO   
 8. STATIC WATER LEVEL Below Top of Casing: 80 FT.  
(Use "+" if Above Top of Casing)

9. TOP OF CASING IS 1 FT. Above Land Surface\*  
\*Top of casing terminated at/or below land surface requires a variance in accordance with 15A NCAC 2C.0118  
 10. YIELD (gpm): 4 METHOD OF TEST Air  
 11. WATER ZONES (depth): 0.50 gpm 235-236 0.50 gpm 248-249  
3.00 gpm 255-256 0.00 gpm  
 12. CHLORINATION: Type HTH Amount 39

13. CASING:

From	To	Depth	Diameter	Wall Thickness or Weight/Ft.	Material
0	70	Ft.	6 1/8	350	PVC
70	265	Ft.			

14. GROUT:

From	To	Depth	Material	Method
0	20	Ft.	Cement	Gravity Flow
20	265	Ft.		


15. SCREEN:

From	To	Depth	Diameter	Slot Size	Material
		Ft.	in.	in.	
		Ft.	in.	in.	
		Ft.	in.	in.	

16. SAND/GRAVEL PACK:

From	To	Depth	Size	Material
		Ft.		
		Ft.		

17. REMARKS: \_\_\_\_\_  
 I DO HEREBY CERTIFY THAT THIS WELL WAS CONSTRUCTED IN ACCORDANCE WITH 15A NCAC 2C, WELL CONSTRUCTION STANDARDS, AND THAT A COPY OF THIS RECORD HAS BEEN PROVIDED TO THE WELL OWNER.

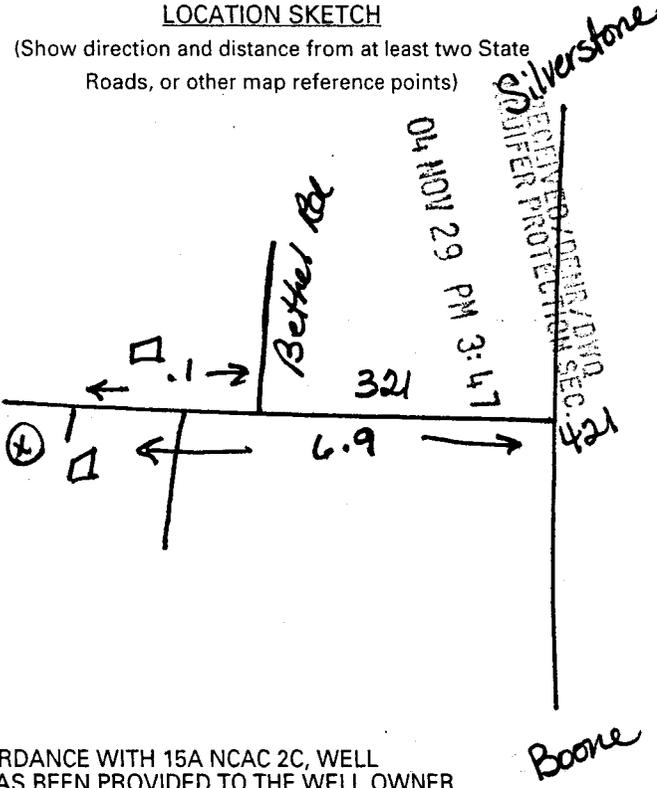

**FOR OFFICE USE ONLY**  
 Quad No: \_\_\_\_\_  
 Serial No: \_\_\_\_\_

Steve Price  
 SIGNATURE OF PERSON CONSTRUCTING THE WELL  
 Submit original to Division of Water Quality, Groundwater Section within 30 days  
 DATE 11-18-04  
 GW-1 REV. 12/99