

232816

**WELL CONSTRUCTION RECORD**

010328

WELL CONTRACTOR: Dewey Wright Well Pump Co., Inc.  
 WELL CONTRACTOR CERTIFICATION #: 2686  
 STATE WELL CONSTRUCTION PERMIT#: Leslie Reece

1. WELL USE (Check Applicable Box): Residential  Municipal  Industrial  Agricultural  Monitoring   
 Recovery  Heat Pump Water Injection  Other  If Other, List Use: \_\_\_\_\_

2. WELL LOCATION: (Show sketch of the location below)  
 Nearest Town: BANNER ELK County: AVERY  
ROCKY PARKWAY TWIN POND OFF SHAWNEE RD OFF  
(Road Name and Numbers, Community, or Subdivision and Lot No.)

DRILLING LOG			DEPTH
RD	From	To	Formation Description
	0	5	DIRT
	5	35	GRANITE
	35	38	QUARTZ
	38	97	GRANITE
	97	98	SHALE
	98	185	GRANITE

RECEIVED ADRHR  
DWD GROUNDWATER SECTION  
01 JUN 14 AM 10:38

4. DATE DRILLED 5/10/2001  
 5. TOTAL DEPTH 185  
 6. CUTTINGS COLLECTED YES  NO   
 7. DOES WELL REPLACE EXISTING WELL? YES  NO   
 8. STATIC WATER LEVEL Below Top of Casing: 60 FT.  
(Use "+" if Above Top of Casing)  
 9. TOP OF CASING IS 1 FT. Above Land Surface\*  
\*Top of casing terminated at/or below land surface requires a variance in accordance with 15A NCAC 2C.0118.  
 10. YIELD (gpm): 12 METHOD OF TEST Air  
 11. WATER ZONES (depth): 1 gpm 35-38 11 gpm 97-98  
0 gpm 0 gpm  
 12. CHLORINATION: Type HTH Amount 26

13. CASING:

From	To	Depth	Diameter	Wall Thickness or Weight/Ft.	Material
From <u>0</u>	To <u>21</u>	<u>21</u> Ft.	<u>8 1/4</u>	<u>.188</u>	<u>PVC</u>
From _____	To _____	_____ Ft.	_____	_____	_____
From _____	To _____	_____ Ft.	_____	_____	_____

LOCATION SKETCH  
 (Show direction and distance from at least two State Roads, or other map reference points)

14. GROUT:

From	To	Depth	Material	Method
From <u>0</u>	To <u>20</u>	<u>20</u> Ft.	<u>Cement</u>	<u>Gravity Flow</u>
From _____	To _____	_____ Ft.	<u>CEMENT</u>	<u>GRAVITY FLOW</u>


15. SCREEN:

From	To	Depth	Diameter	Slot Size	Material
From _____	To _____	_____ Ft.	_____ in.	_____ in.	_____
From _____	To _____	_____ Ft.	_____ in.	_____ in.	_____
From _____	To _____	_____ Ft.	_____ in.	_____ in.	_____

16. SAND/GRAVEL PACK:

From	To	Depth	Size	Material
From _____	To _____	_____ Ft.	_____	_____
From _____	To _____	_____ Ft.	_____	_____

17. REMARKS:  
 I DO HEREBY CERTIFY THAT THIS WELL WAS CONSTRUCTED IN ACCORDANCE WITH 15A NCAC 2C, WELL CONSTRUCTION STANDARDS, AND THAT A COPY OF THIS RECORD HAS BEEN PROVIDED TO THE WELL OWNER.

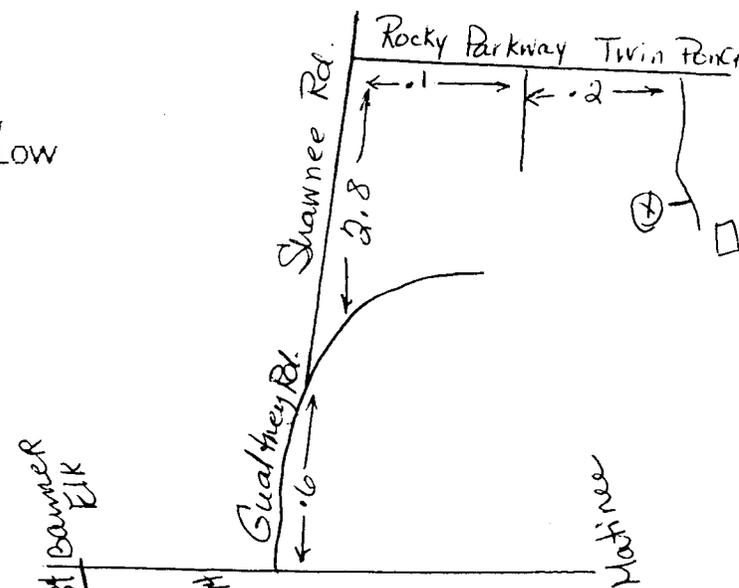

FOR OFFICE USE ONLY  
 Quad No: \_\_\_\_\_  
 Serial No. \_\_\_\_\_

Leslie Wayne Reece 6-6-01  
 SIGNATURE OF PERSON CONSTRUCTING THE WELL DATE