

237855

WELL CONSTRUCTION RECORD

010650

WELL CONTRACTOR: Dewey Wright Well Pump Co., Inc.
 WELL CONTRACTOR CERTIFICATION #: 2686
 STATE WELL CONSTRUCTION PERMIT#: Leslie Reece

1. WELL USE (Check Applicable Box): Residential Municipal Industrial Agricultural Monitoring
 Recovery Heat Pump Water Injection Other If Other, List Use: _____

2. WELL LOCATION: (Show sketch of the location below)
 Nearest Town: BANNER ELK County: ALBERT
DEV RD. IN ROCKY PARKWAY OFF SHAWNEE RD. OFF
(Road Name and Numbers, Community, or Subdivision and Lot No.)

| DRILLING LOG | | DEPTH |
|--------------|-----|-----------------------|
| From | To | Formation Description |
| 0 | 13 | DIRT |
| 13 | 211 | GRANITE |
| 211 | 212 | SHALE |
| 212 | 344 | GRANITE |
| 344 | 345 | QUARTZ |
| 345 | 400 | GRANITE |

4. DATE DRILLED 7/30/2001
 5. TOTAL DEPTH 400
 6. CUTTINGS COLLECTED YES NO
 7. DOES WELL REPLACE EXISTING WELL? YES NO
 8. STATIC WATER LEVEL Below Top of Casing: 50 FT.
(Use "+" if Above Top of Casing)

9. TOP OF CASING IS 1 FT. Above Land Surface*
*Top of casing terminated at/or below land surface requires a variance in accordance with 15A NCAC 2C 0118

10. YIELD (gpm): 4 METHOD OF TEST Air
 11. WATER ZONES (depth): 2 gpm 211-212 2 gpm 344-345
0 gpm 0 gpm

12. CHLORINATION: Type HTH Amount _____

13. CASING:

| From | To | Depth | Diameter | Wall Thickness or Weight/Ft. | Material |
|------|----|-------|----------|------------------------------|----------|
| 0 | 24 | Ft. | 6 1/4 | .188 | GALV. |
| From | To | Ft. | | | |
| From | To | Ft. | | | |

14. GROUT:

| From | To | Depth | Material | Method |
|------|----|-------|----------|--------------|
| 0 | 20 | Ft. | Cement | Gravity Flow |
| From | To | Ft. | | |


15. SCREEN:

| From | To | Depth | Diameter | Slot Size | Material |
|------|----|-------|----------|-----------|----------|
| From | To | Ft. | in. | in. | |
| From | To | Ft. | in. | in. | |
| From | To | Ft. | in. | in. | |


16. SAND/GRAVEL PACK:

| From | To | Depth | Size | Material |
|------|----|-------|------|----------|
| From | To | Ft. | | |
| From | To | Ft. | | |

17. REMARKS: _____
 I DO HEREBY CERTIFY THAT THIS WELL WAS CONSTRUCTED IN ACCORDANCE WITH 15A NCAC 2C, WELL CONSTRUCTION STANDARDS, AND THAT A COPY OF THIS RECORD HAS BEEN PROVIDED TO THE WELL OWNER.

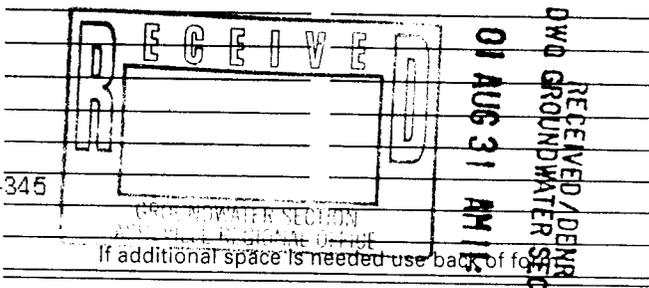

LOCATION SKETCH
 (Show direction and distance from at least two State Roads, or other map reference points)

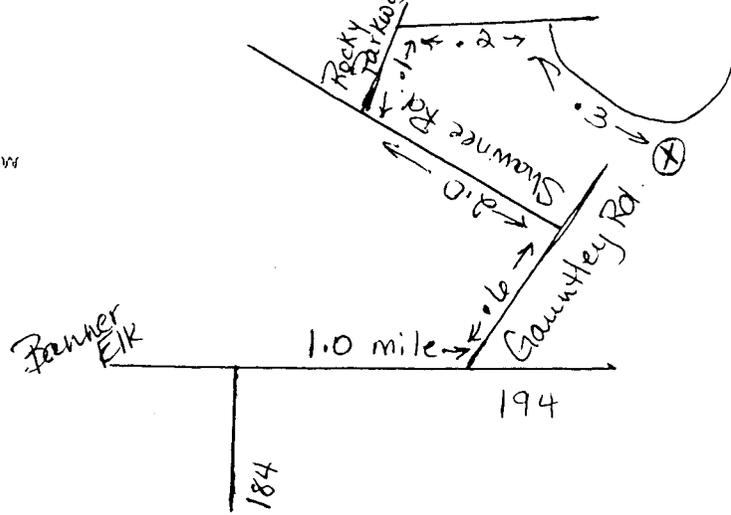

FOR OFFICE USE ONLY
 Quad No: _____
 Serial No. _____

Leslie Wayne Reece 8-28-01
 SIGNATURE OF PERSON CONSTRUCTING THE WELL DATE
 Submit original to Division of Water Quality, Groundwater Section within 30 days