99 003

North Carolina - Department of Environment, Health, and Natural Resources
Division of Environmental Management - Groundwater Section
P.O. Box 29535 - Raleigh, N.C. 27626-0535
Phone (919) 733-3221

FOR OFFICE USE ONLY
QUAD. NO. _____ SERIAL NO. 194487
Lat. _____ Long. _____ Pc _____
Minor Basin _____
Basin Code _____
Header Ent. _____ GW-1 Ent. _____

WELL CONSTRUCTION RECORD

DRILLING CONTRACTOR: ~~Dewey Wright Well & Pump Co. Inc.~~

STATE WELL CONSTRUCTION PERMIT NUMBER: S. Reece

DRILLER REGISTRATION NUMBER: 266

1. WELL LOCATION: (Show sketch of the location below)
Nearest Town: Altamonte County: AVERY
OFF OLD 3 MILE ROAD
(Road, Community, or Subdivision and Lot No.)

2.

DEPTH From	DEPTH To	DRILLING LOG Formation Description
0	40	DIRT
40	58	GRANITE
58	60	SHALE
60	180	GRANITE
180	183	QUARTZ
183	200	GRANITE

3. DATE DRILLED 01/14/99 USE OF WELL PVT
4. TOTAL DEPTH 200'
5. CUTTINGS COLLECTED YES [ ] NO [x]
6. DOES WELL REPLACE EXISTING WELL? YES [ ] NO [x]
7. STATIC WATER LEVEL Below Top of Casing: 20 FT.
(Use "+" if Above Top of Casing)
8. TOP OF CASING IS 1 FT. Above Land Surface*
* Casing Terminated at/or below land surface is illegal unless a variance is issued in accordance with 15A NCAC 2C .0118
9. YIELD (gpm): 4 METHOD OF TEST AIR
10. WATER ZONES (depth): ~~2 gpm 58-60' 2 gpm 180-183'~~
11. CHLORINATION: Type ~~HTH~~ Amount ~~38 tabs~~

If additional space is needed use back of form

12. CASING:

Depth From	Depth To	Diameter	Wall Thickness or Weight/Ft.	Material
0	42	6 1/4	0.188	GALV

13. GROUT:

Depth From	Depth To	Material	Method
~~0~~	~~20~~	~~CEMENT~~	~~PUMPED~~

14. SCREEN:

Depth From	Depth To	Diameter	Slot Size	Material

15. SAND/GRAVEL PACK:

Depth From	Depth To	Size	Material

LOCATION SKETCH
(Show direction and distance from at least two State Roads, or other map reference points)

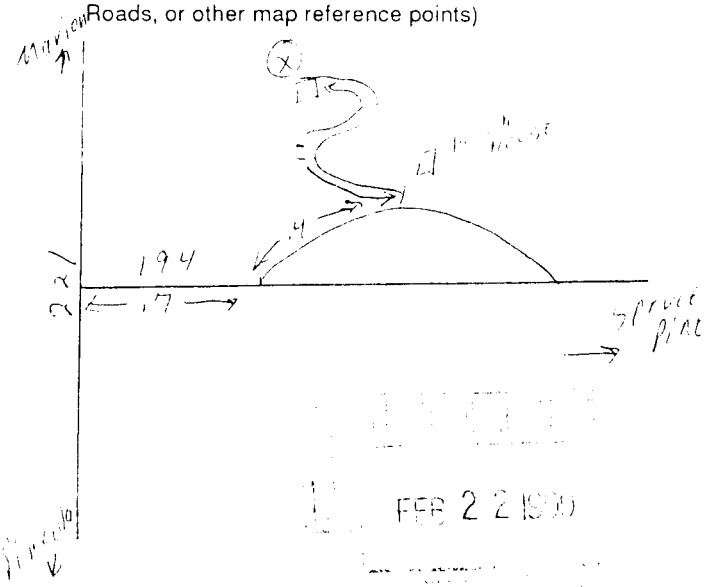

16. REMARKS:

I HEREBY CERTIFY THAT THIS WELL WAS CONSTRUCTED IN ACCORDANCE WITH 15A NCAC 2C, WELL CONSTRUCTION STANDARDS, AND THAT A COPY OF THIS RECORD HAS BEEN PROVIDED TO THE WELL OWNER.

Barbara K. Aden 2/17/99
SIGNATURE OF CONTRACTOR OR AGENT DATE

Submit original to Division of Environmental Management and copy to well owner

RECEIVED
99 FEB 25 PM 12:54
GROUNDWATER SECTION

FEB 22 1999

GW-1 REV. 5/91