99 435

North Carolina - Department of Environment, Health, and Natural Resources
Division of Environmental Management - Groundwater Section
P.O. Box 29535 - Raleigh, N.C. 27626-0535
Phone (919) 733-3221

FOR OFFICE USE ONLY 204736
QUAD. NO. _____ SERIAL NO. _____
Lat. _____ Long. _____ Pc. _____
Minor Basin _____
Basin Code _____
Header Ent. _____ GW-1 Ent. _____

WELL CONSTRUCTION RECORD

DRILLING CONTRACTOR: Dewey Wright Well & Pump Co., Inc.

DRILLER REGISTRATION NUMBER: 266

STATE WELL CONSTRUCTION PERMIT NUMBER: W. Recce

1. WELL LOCATION: (Show sketch of the location below)
   Nearest Town: Banner Elk County: AVERY
   .1 M DOWN PVT DR OFF 194 6.1 M FROM 184
   (Road, Community, or Subdivision and Lot No.)

2.

DEPTH From	DEPTH To	DRILLING LOG Formation Description
0	35	DIRT
35	181	GRANITE
181	182	SHALE
182	225	GRANITE

3. DATE DRILLED 07/23/99 USE OF WELL PVT
4. TOTAL DEPTH 225'
5. CUTTINGS COLLECTED YES [ ] NO [x]
6. DOES WELL REPLACE EXISTING WELL? YES [ ] NO [x]
7. STATIC WATER LEVEL Below Top of Casing: 50 FT.
   (Use "+" if Above Top of Casing)
8. TOP OF CASING IS 1 FT. Above Land Surface*
   * Casing Terminated at/or below land surface is illegal unless a variance is issued in accordance with 15A NCAC 2C .0118
9. YIELD (gpm): 6 METHOD OF TEST AIR
10. WATER ZONES (depth): 6 gpm 181-182'
11. CHLORINATION: Type HTH Amount 37 tabs
12. CASING:

Depth From	To	Ft.	Diameter	Wall Thickness or Weight/Ft.	Material
0	42		6 1/4	0.188	GALV

13. GROUT:

Depth From	To	Ft.	Material	Method
0	20		CEMENT	PUMPED

14. SCREEN:

Depth From	To	Ft.	Diameter	Slot Size	Material
			in.	in.	

15. SAND/GRAVEL PACK:

Depth From	To	Ft.	Size	Material

16. REMARKS:

If additional space is needed use back of form

LOCATION SKETCH
(Show direction and distance from at least two State Roads, or other map reference points)

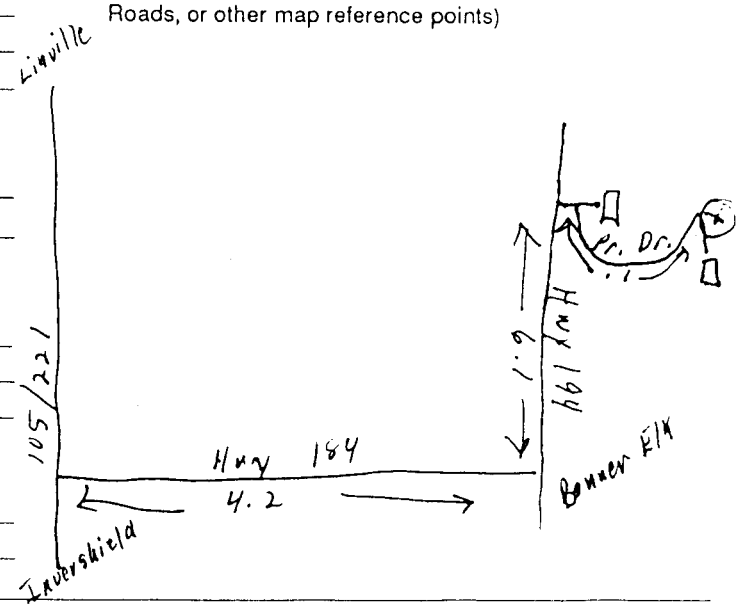

I DO HEREBY CERTIFY THAT THIS WELL WAS CONSTRUCTED IN ACCORDANCE WITH 15A NCAC 2C, WELL CONSTRUCTION STANDARDS, AND THAT A COPY OF THIS RECORD HAS BEEN PROVIDED TO THE WELL OWNER.

RECEIVED NOV 29 1999 Groundwater Section Asheville Regional Office

RECEIVED DEC Groundwater Section Asheville Regional Office

Barbara K. Aden 11/17/99
SIGNATURE OF CONTRACTOR OR AGENT DATE

Submit original to Division of Environmental Management and copy to well owner

GW-1 REV 7/1