99 499

North Carolina - Department of Environment, Health, and Natural Resources
Division of Environmental Management - Groundwater Section
P.O. Box 29535 - Raleigh, N.C. 27626-0535
Phone (919) 733-3221

FOR OFFICE USE ONLY
QUAD. NO. _____ SERIAL NO. 205355
Lat. _____ Long. _____ Pc _____
Minor Basin _____
Basin Code _____
Header Ent. _____ GW-1 Ent.

WELL CONSTRUCTION RECORD

DRILLING CONTRACTOR: Dewey Wright Well & Pump Co. Inc.

DRILLER REGISTRATION NUMBER: 266 **STATE WELL CONSTRUCTION PERMIT NUMBER:** K. Jordan

1. WELL LOCATION: (Show sketch of the location below)
   Nearest Town: Newland County: AVERY
   OFF HWY 19E
   (Road, Community, or Subdivision and Lot No.)

2.

DEPTH From	DEPTH To	DRILLING LOG Formation Description
0	10	BRN DIRT/MUD/BOLDRS
10	72	SHALE ROCK
72	92	GRANITE
92	95	SHALE ROCK
95	127	GRANITE
127	132	SHALE
132	200	GRANITE

3. DATE DRILLED 08/16/99 USE OF WELL PVT
4. TOTAL DEPTH 200'
5. CUTTINGS COLLECTED YES [ ] NO [x]
6. DOES WELL REPLACE EXISTING WELL? YES [ ] NO [x]
7. STATIC WATER LEVEL Below Top of Casing: 10 FT.
   (Use "+" if Above Top of Casing)
8. TOP OF CASING IS 1 FT. Above Land Surface*

* Casing Terminated at/or below land surface is illegal unless a variance is issued in accordance with 15A NCAC 2C .0118

9. YIELD (gpm): 10 METHOD OF TEST AIR
10. WATER ZONES (depth): 2 gpm 92-95' 8 gpm 127-132'
11. CHLORINATION: Type HTH Amount 40 tabs

If additional space is needed use back of form

RECEIVED/DENR GROUNDWATER SECTION 00 JAN -5 PM 3:26 DWQ

12. CASING:

From	To	Ft.	Diameter	Wall Thickness or Weight/Ft.	Material
0	77		6 1/4	0.188	GALV.

13. GROUT:

From	To	Ft.	Material	Method
0	20		CEMENT	PUMPED

14. SCREEN:

From	To	Ft	Diameter	Slot Size	Material
			in.	in.	
			in.	in.	
			in.	in.	

15. SAND/GRAVEL PACK:

From	To	Ft.	Size	Material

16. REMARKS:

LOCATION SKETCH
(Show direction and distance from at least two State Roads, or other map reference points)

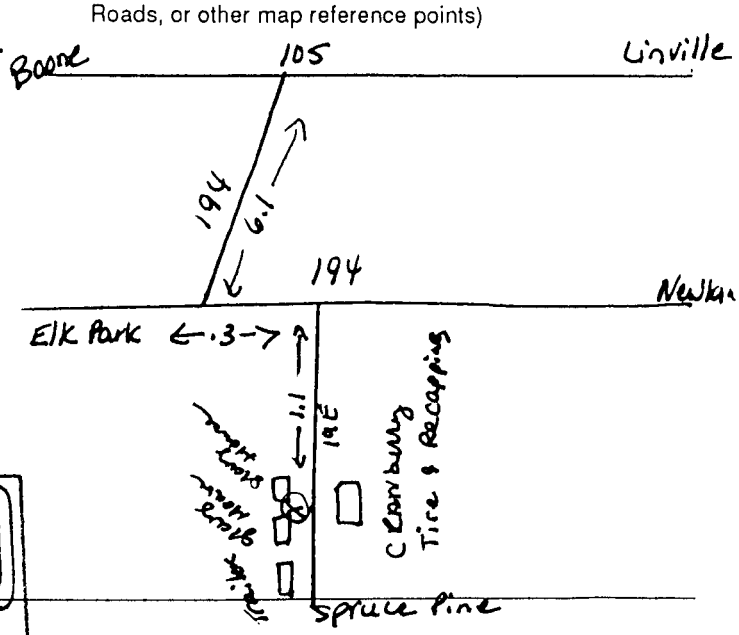

RECEIVED JAN 10 2000 Groundwater Section Asheville Regional Office

I DO HEREBY CERTIFY THAT THIS WELL WAS CONSTRUCTED IN ACCORDANCE WITH 15A NCAC 2C, WELL CONSTRUCTION STANDARDS, AND THAT A COPY OF THIS RECORD HAS BEEN PROVIDED TO THE WELL OWNER.

RECEIVED DEC 28 1999 Groundwater Section Asheville Regional Office

Mary Owens 12-21-99
SIGNATURE OF CONTRACTOR OR AGENT DATE

GW-1 REV. 5/91 Submit original to Division of Environmental Management and copy to well owner.