99 7201

North Carolina - Department of Environment, Health, and Natural Resources
Division of Environmental Management - Groundwater Section
P.O. Box 29535 - Raleigh, N.C. 27626-0535
Phone (919) 733-3221

FOR OFFICE USE ONLY 206304
QUAD. NO. _____ SERIAL NO. _____
Lat. _____ Long. _____ Pc _____
Minor Basin _____
Basin Code _____
Header Ent. _____ GW-1 Ent. _____

WELL CONSTRUCTION RECORD

DRILLING CONTRACTOR: Dewey Wright Well & Pump Co., Inc.

DRILLER REGISTRATION NUMBER: 266

STATE WELL CONSTRUCTION PERMIT NUMBER: K. Jordan

1. WELL LOCATION: (Show sketch of the location below)
Nearest Town: Elk Park County: AVERY
OFF MILES FIELD DR. OFF BUCK MTN OFF 19E
(Road, Community, or Subdivision and Lot No.)

2.

DEPTH From	DEPTH To	DRILLING LOG Formation Description
0	30	BRN DRT/MUD/GRNT
30	600	SLATE/WHT/PNKQURTZ

State Zip Code

3. DATE DRILLED 10/12/99 USE OF WELL PVT
4. TOTAL DEPTH 600'
5. CUTTINGS COLLECTED YES [ ] NO [x]
6. DOES WELL REPLACE EXISTING WELL? YES [ ] NO [x]
7. STATIC WATER LEVEL Below Top of Casing: 0 FT.
(Use "+" if Above Top of Casing)
8. TOP OF CASING IS 1 FT. Above Land Surface*
* Casing Terminated at/or below land surface is illegal unless a variance is issued in accordance with 15A NCAC 2C .0118
9. YIELD (gpm): 0 METHOD OF TEST AIR
10. WATER ZONES (depth): DRY gpm HOLE'
11. CHLORINATION: Type HTH Amount 0 tabs
12. CASING:

Depth From	To	Ft.	Diameter	Wall Thickness or Weight/Ft	Material
0	30		6 1/4	0.188	GALV.

13. GROUT:

Depth From	To	Ft.	Material	Method
0	20		CEMENT	PUMPED

14. SCREEN:

Depth From	To	Ft.	Diameter	Slot Size	Material
			in.	in.	

15. SAND/GRAVEL PACK:

Depth From	To	Ft.	Size	Material

16. REMARKS:

If additional space is needed use back of form

00 FEB -3 AM 10:23
DWQ GROUNDWATER SECTION

LOCATION SKETCH
(Show direction and distance from at least two State Roads, or other map reference points)

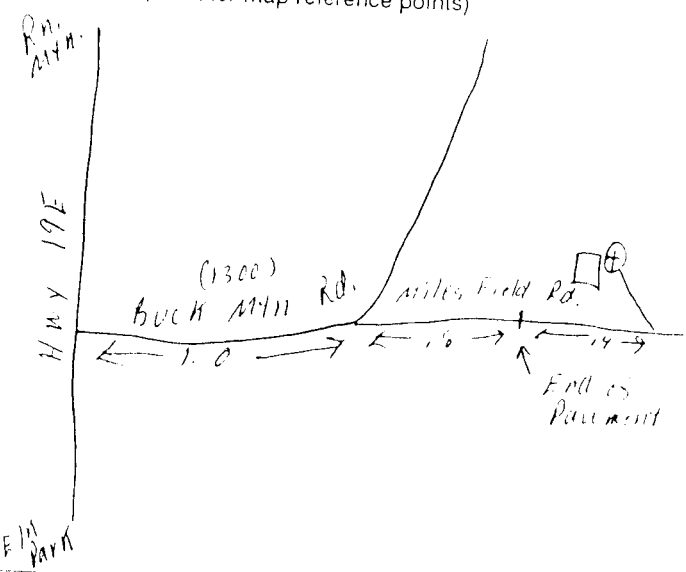

I DO HEREBY CERTIFY THAT THIS WELL WAS CONSTRUCTED IN ACCORDANCE WITH 15A NCAC 2C, WELL CONSTRUCTION STANDARDS, AND THAT A COPY OF THIS RECORD HAS BEEN PROVIDED TO THE WELL OWNER.

RECEIVED
JAN 26 2000
Groundwater Section
Asheville Regional Office

Barbara K. Aden 1/20/00
SIGNATURE OF CONTRACTOR OR AGENT DATE

Submit original to Division of Environmental Management and copy to well owner

GW-1 REV. 5/91