99 874

North Carolina - Department of Environment, Health, and Natural Resources
Division of Environmental Management - Groundwater Section
P.O. Box 29535 - Raleigh, N.C. 27626-0535
Phone (919) 733-3221

FOR OFFICE USE ONLY
QUAD. NO. _____ SERIAL NO. 208498
Lat. _____ Long. _____ Pc _____
Minor Basin _____
Basin Code _____
Header Ent. _____ GW-1 Ent. _____

WELL CONSTRUCTION RECORD

DRILLING CONTRACTOR: Dewey Wright Well & Pump Co., Inc.

STATE WELL CONSTRUCTION PERMIT NUMBER: _____

DRILLER REGISTRATION NUMBER: 2681

1. WELL LOCATION: (Show sketch of the location below)
Nearest Town: ELK MILLS County: AVERY
OFF BUCKEYE RD. OFF HWY 321
(Road, Community, or Subdivision and Lot No.)

2. _____
City or Town State Zip Code

3. DATE DRILLED 02/10/00 USE OF WELL PVT
4. TOTAL DEPTH 405'
5. CUTTINGS COLLECTED YES [ ] NO [X]
6. DOES WELL REPLACE EXISTING WELL? YES [ ] NO [X]
7. STATIC WATER LEVEL Below Top of Casing: 20 FT.
(Use "+" if Above Top of Casing)
8. TOP OF CASING IS 1 FT. Above Land Surface*
* Casing Terminated at/or below land surface is illegal unless a variance is issued in accordance with 15A NCAC 2C .0118
9. YIELD (gpm): 2 METHOD OF TEST AIR
10. WATER ZONES (depth): 1/2 gpm 86-87' 1.5 gpm 395-396'

DEPTH From	DEPTH To	DRILLING LOG Formation Description
0	15	DIRT
15	86	GRANITE
86	87	QUARTZ
87	395	GRANITE
395	396	SHALE
396	405	GRANITE

If additional space is needed use back of form

11. CHLORINATION: Type HTH Amount 76 tabs
12. CASING:

	Depth From	Depth To	Diameter	Wall Thickness or Weight/Ft.	Material
		Ft.			
	0	21 Ft.	6 1/4	0.188	GALV.
		Ft.			

13. GROUT:

Depth From	Depth To	Material	Method
0	20 Ft.	CEMENT	Gravity Flow
	Ft.		

14. SCREEN:

Depth From	Depth To	Diameter	Slot Size	Material
	Ft	in.	in.	
	Ft.	in.	in.	
	Ft.	in.	in.	

15. SAND/GRAVEL PACK:

Depth From	Depth To	Size	Material
	Ft.		
	Ft.		

LOCATION SKETCH
(Show direction and distance from at least two State Roads, or other map reference points)

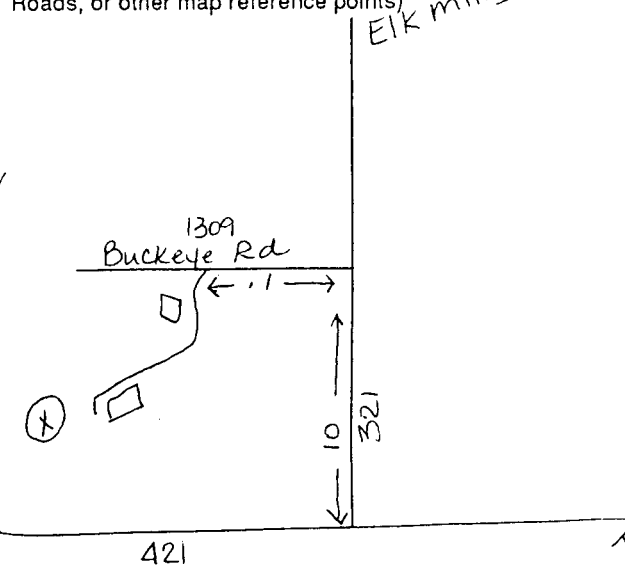

16. REMARKS: _____

I DO HEREBY CERTIFY THAT THIS WELL WAS CONSTRUCTED IN ACCORDANCE WITH 15A NCAC 2C, WELL CONSTRUCTION STANDARDS, AND THAT A COPY OF THIS RECORD HAS BEEN PROVIDED TO THE WELL OWNER.

RECEIVED MAR - 5 2000

Steve Petty
Stephen Petty
SIGNATURE OF CONTRACTOR OR AGENT

3-31-00
DATE

00 APR 10 PM 2:56