213290

North Carolina - Department of Environment and Natural Resources - Division of Water Quality - Groundwater Section
1636 Mail Service Center - Raleigh, N.C. 27699-1636-Phone (919) 733-3221

WELL CONSTRUCTION RECORD

WELL CONTRACTOR: Braswell Well Drilling
WELL CONTRACTOR CERTIFICATION #: 2388
STATE WELL CONSTRUCTION PERMIT#:

1. WELL USE (Check Applicable Box): Residential ☑ Municipal ☐ Industrial ☐ Agricultural ☐ Monitoring ☐ Recovery ☐ Heat Pump Water Injection ☐ Other ☐ If Other, List Use:

2. WELL LOCATION: (Show sketch of the location below)
Nearest Town: Newland County: Avery
Blevin CR
(Road Name and Numbers, Community, or Subdivision and Lot No.)

3.

DRILLING LOG From	To	DEPTH Formation Description
0-	64	red, brown clay & gravel
64	140	granite
140-	145	shale rock
145	500	granite white, pink & quartz

If additional space is needed use back of form

4. DATE DRILLED 6-16-2000
5. TOTAL DEPTH 500
6. CUTTINGS COLLECTED YES ☐ NO ☑
7. DOES WELL REPLACE EXISTING WELL? YES ☐ NO ☑
8. STATIC WATER LEVEL Below Top of Casing: 180 FT.
(Use "+" If Above Top of Casing)
9. TOP OF CASING IS 1 FT. Above Land Surface*
*Top of casing terminated at/or below land surface requires a variance in accordance with 15A NCAC 2C .0118
10. YIELD (gpm): 2 METHOD OF TEST Air
11. WATER ZONES (depth): 140 ft
12. CHLORINATION: Type HTH Amount 3 oz
13. CASING:

Depth From	To	Ft.	Diameter	Wall Thickness or Weight/Ft.	Material
-1	64		6	SDR21	PVC

14. GROUT:

Depth From	To	Ft.	Material	Method
0	20		cement	poured

15. SCREEN:

Depth From	To	Ft	Diameter	Slot Size	Material
			in.	in.	
			in.	in.	
			in.	in.	

16. SAND/GRAVEL PACK:

Depth From	To	Ft.	Size	Material

17. REMARKS:

LOCATION SKETCH
(Show direction and distance from at least two State Roads, or other map reference points)

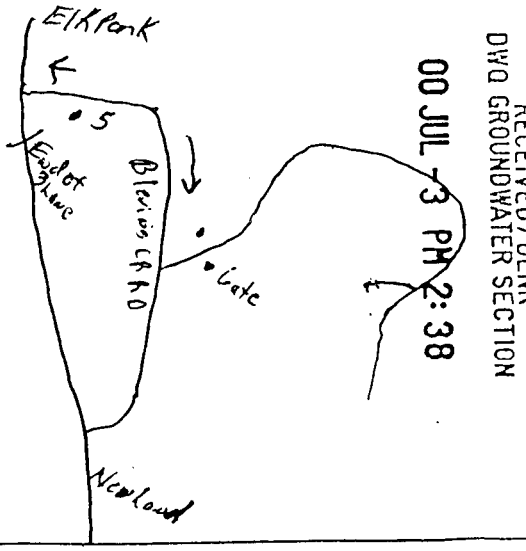

RECEIVED
JUN 23 2000
Groundwater Section
Asheville Regional Office

RECEIVED/DENR
DWQ GROUNDWATER SECTION
00 JUL -3 PM 2:38

I DO HEREBY CERTIFY THAT THIS WELL WAS CONSTRUCTED IN ACCORDANCE WITH 15A NCAC 2C, WELL CONSTRUCTION STANDARDS, AND THAT A COPY OF THIS RECORD HAS BEEN PROVIDED TO THE WELL OWNER.

Chris E Braswell 6-22-00
SIGNATURE OF PERSON CONSTRUCTING THE WELL DATE

Submit original to Division of Water Quality, Groundwater Section within 30 days

FOR OFFICE USE ONLY
Quad No:
Serial No.

GW-1 REV. 12/99