North Carolina - Department of Environment and Natural Resources - Division of Water Quality - Groundwater Section
1636 Mail Service Center - Raleigh, N.C. 27699-1636-Phone (919) 733-3221

119890

WELL CONSTRUCTION RECORD

WELL CONTRACTOR: Sweetwater Well & Pump Inc
WELL CONTRACTOR CERTIFICATION #: 2784
STATE WELL CONSTRUCTION PERMIT#:

1. WELL USE (Check Applicable Box): Residential [X] Municipal [ ] Industrial [ ] Agricultural [ ] Monitoring [ ] Recovery [ ] Heat Pump Water Injection [ ] Other [ ] If Other, List Use:

2. WELL LOCATION: (Show sketch of the location below)
Nearest Town: Spruce Pine County: Avery County
Prisoor Camp Rd
(Road Name and Numbers, Community, or Subdivision and Lot No.)

3.

DRILLING LOG From	To	DEPTH Formation Description

City or Town State Zip Code

4. DATE DRILLED 9/1/2000
5. TOTAL DEPTH 125
6. CUTTINGS COLLECTED YES [ ] NO [X]
7. DOES WELL REPLACE EXISTING WELL? YES [ ] NO [X]
8. STATIC WATER LEVEL Below Top of Casing: 5 FT.
(Use "+" if Above Top of Casing)
9. TOP OF CASING IS 1½ FT. Above Land Surface*
*Top of casing terminated at/or below land surface requires a variance in accordance with 15A NCAC 2C .0118
10. YIELD (gpm): 30 METHOD OF TEST Time
11. WATER ZONES (depth): 35'
12. CHLORINATION: Type TAB Amount 3

If additional space is needed use back of form

13. CASING:

	Depth From	To	Diameter	Wall Thickness or Weight/Ft.	Material
	0	30 Ft.	6 5/8	SDR 21	PVC
		Ft.			
		Ft.			

14. GROUT:

	Depth From	To	Material	Method
	0	20 Ft.	Cement	Mixing
		Ft.		

15. SCREEN:

	Depth From	To	Diameter	Slot Size	Material
		Ft	in.	in.	
		Ft.	in.	in.	
		Ft.	in.	in.	

16. SAND/GRAVEL PACK:

	Depth From	To	Size	Material
		Ft.		
		Ft.		

17. REMARKS:

LOCATION SKETCH
(Show direction and distance from at least two State Roads, or other map reference points)

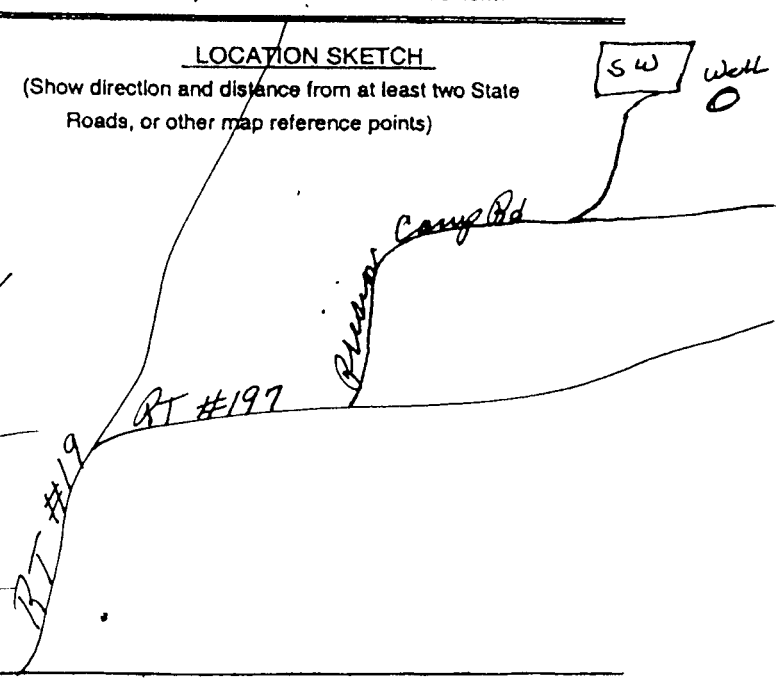

I DO HEREBY CERTIFY THAT THIS WELL WAS CONSTRUCTED IN ACCORDANCE WITH 15A NCAC 2C, WELL CONSTRUCTION STANDARDS, AND THAT A COPY OF THIS RECORD HAS BEEN PROVIDED TO THE WELL OWNER.

RECEIVED

FOR OFFICE USE ONLY
Quad No:
Serial No.

SIGNATURE OF PERSON CONSTRUCTING THE WELL DATE 9/1/2000

Submit original to Division of Water Quality, Groundwater Section within 30 days

GW-1 REV. 12/99

Groundwater Section
Asheville Regional Office