North Carolina - Department of Environment and Natural Resources - Division of Water Quality - Groundwater Section
1636 Mail Service Center - Raleigh, N.C. 27699-1636-Phone (919) 733-3221

243817

WELL CONSTRUCTION RECORD

WELL CONTRACTOR: Braswell Well Drilling
WELL CONTRACTOR CERTIFICATION #: 2133
STATE WELL CONSTRUCTION PERMIT#:

1. WELL USE (Check Applicable Box): Residential ☑ Municipal ☐ Industrial ☐ Agricultural ☐ Monitoring ☐
Recovery ☐ Heat Pump Water Injection ☐ Other ☐ If Other, List Use:

2. WELL LOCATION: (Show sketch of the location below)
Nearest Town: Heaton - Banner Elk County: Avery
Reuben Wooten Rd off Hwy 194
(Road Name and Numbers, Community, or Subdivision and Lot No.)

City or Town State Zip Code

3. DRILLING LOG

From	To	DEPTH Formation Description
0	20	dirt
20	70	Br. shell (soft)
70	220	granite

If additional space is needed use back of form

4. DATE DRILLED 5-21-01
5. TOTAL DEPTH 220 ft.
6. CUTTINGS COLLECTED YES ☐ NO ☑
7. DOES WELL REPLACE EXISTING WELL? YES ☐ NO ☑
8. STATIC WATER LEVEL Below Top of Casing: _____ FT.
(Use "+" if Above Top of Casing)
9. TOP OF CASING IS 1 FT. Above Land Surface*
*Top of casing terminated at/or below land surface requires a variance in accordance with 15A NCAC 2C .0118
10. YIELD (gpm): 10 METHOD OF TEST Air Blown
11. WATER ZONES (depth): 90 ft. 175 ft.
12. CHLORINATION: Type chlorine Amount 3 oz.
13. CASING:

	Depth From	To	Diameter	Wall Thickness or Weight/Ft.	Material
	0	82 Ft.	6 1/4	sch 80	PVC
		Ft.			
		Ft.			

14. GROUT:

	Depth From	To	Material	Method
	0	20 Ft.	cement	poured
		Ft.		

15. SCREEN:

	Depth From	To	Diameter	Slot Size	Material
		Ft	in.	in.	
		Ft.	in.	in.	
		Ft.	in.	in.	

16. SAND/GRAVEL PACK:

	Depth From	To	Size	Material
		Ft.		
		Ft.		

17. REMARKS:

LOCATION SKETCH
(Show direction and distance from at least two State Roads, or other map reference points)

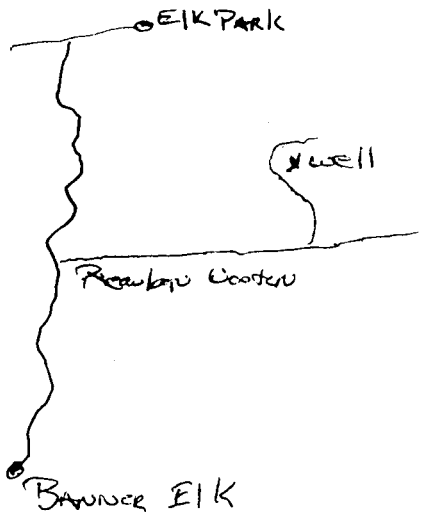

RECEIVED/DENR
DWQ GROUNDWATER SECTION
01 DEC 10 PM 3:15

I DO HEREBY CERTIFY THAT THIS WELL WAS CONSTRUCTED IN ACCORDANCE WITH 15A NCAC 2C, WELL CONSTRUCTION STANDARDS, AND THAT A COPY OF THIS RECORD HAS BEEN PROVIDED TO THE WELL OWNER.

Ken Rogers 5-21-01
SIGNATURE OF PERSON CONSTRUCTING THE WELL DATE

Submit original to Division of Water Quality, Groundwater Section within 30 days

FOR OFFICE USE ONLY
Quad No:
Serial No.

RECEIVED
GROUNDWATER SECTION
ASHEVILLE REGIONAL OFFICE

GW-1 REV. 12/99