North Carolina - Department of Environment and Natural Resources - Division of Water Quality - Groundwater Section
1636 Mail Service Center - Raleigh, N.C. 27699-1636 - Phone (919) 733-3221

251456

WELL CONSTRUCTION RECORD

020134

WELL CONTRACTOR: Dewey Wright Well Pump Co., Inc.
WELL CONTRACTOR CERTIFICATION #: 2688
STATE WELL CONSTRUCTION PERMIT#: Leslie Reece

1. **WELL USE (Check Applicable Box):** Residential [ ] X Municipal [ ] Industrial [ ] Agricultural [ ] Monitoring [ ]
Recovery [ ] Heat Pump Water Injection [ ] Other [ ] If Other, List Use: _____

2. WELL LOCATION: (Show sketch of the location below)
Nearest Town: ELK PARK County: AVERY
DARK HOLLOW RD. OFF DAVIS RD. OFF HWY 19E
(Road Name and Numbers, Community, or Subdivision and Lot No.)

3.

DRILLING LOG From	To	DEPTH Formation Description
0	34	MUD/GRAVEL
34	47	GRANITE
47	49	SHALE
49	305	GRANITE

If additional space is needed use back of form

4. DATE DRILLED 3/26/2002
5. TOTAL DEPTH 305
6. CUTTINGS COLLECTED YES [ ] NO [ ] X
7. DOES WELL REPLACE EXISTING WELL? YES [ ] NO [ ] X
8. STATIC WATER LEVEL Below Top of Casing: 10 FT.
(Use "+" if Above Top of Casing)
9. TOP OF CASING IS 1 FT. Above Land Surface*
*Top of casing terminated at/or below land surface requires a variance in accordance with 15A NCAC 2C.0118
10. YIELD (gpm): 12 METHOD OF TEST Air
11. WATER ZONES (depth): 12 gpm 47-49 0 gpm
0 gpm 0 gpm
12. CHLORINATION: Type HTH Amount 59

RECEIVED/DENR
GROUNDWATER SECTION
02 APR 29 PM 12:45

13. CASING:

	Depth From	To	Diameter	Wall Thickness or Weight/Ft.	Material
	0	37 Ft.	6 1/4	.188	GALV.
		Ft.			
		Ft.			

14. GROUT:

	Depth From	To	Material	Method
	0	20 Ft.	Cement	Gravity Flow
		Ft.		

15. SCREEN:

	Depth From	To	Diameter	Slot Size	Material
		Ft.	in.	in.	
		Ft.	in.	in.	
		Ft.	in.	in.	

16. SAND/GRAVEL PACK:

	Depth From	To	Size	Material
		Ft.		
		Ft.		

LOCATION SKETCH
(Show direction and distance from at least two State Roads, or other map reference points)

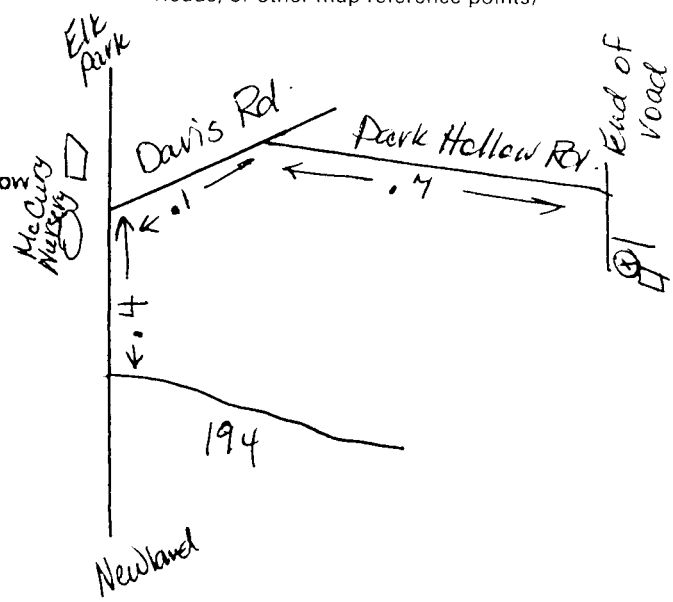

17. REMARKS:
I DO HEREBY CERTIFY THAT THIS WELL WAS CONSTRUCTED IN ACCORDANCE WITH 15A NCAC 2C, WELL CONSTRUCTION STANDARDS, AND THAT A COPY OF THIS RECORD HAS BEEN PROVIDED TO THE WELL OWNER.

RECEIVED
ASHEVILLE REGIONAL OFFICE

Leslie Wayne Reece
SIGNATURE OF PERSON CONSTRUCTING THE WELL DATE
Submit original to Division of Water Quality, Groundwater Section within 30 days

FOR OFFICE USE ONLY
Quad No: _____
Serial No. _____

GW-1 REV. 12/99