271163

WELL CONSTRUCTION RECORD

North Carolina - Department of Environment and Natural Resources - Division of Water Quality - Groundwater Section

WELL CONTRACTOR (INDIVIDUAL) NAME (print) Kenneth Jordan CERTIFICATION # 2669

WELL CONTRACTOR COMPANY NAME Braswell PHONE # ( )

STATE WELL CONSTRUCTION PERMIT# _____ (if applicable) ASSOCIATED WQ PERMIT# _____ (if applicable)

1. WELL USE (Check Applicable Box): Residential ☑ Municipal/Public ☐ Industrial ☐ Agricultural ☐ Monitoring ☐ Recovery ☐ Heat Pump Water Injection ☐ Other ☐ If Other, List Use private

2. WELL LOCATION:
Nearest Town: Beech Mnt County Avery
Beech Mnt RD 2 mile up on LT
(Street Name, Numbers, Community, Subdivision, Lot No., Zip Code)

Topographic/Land setting
☑ Ridge ☐ Slope ☐ Valley ☐ Flat
(check appropriate box)
Latitude/longitude of well location
_____
(degrees/minutes/seconds)
Latitude/longitude source: ☐ GPS ☐ Topographic map
(check box)

3. _____
Area code- Phone number

4. DATE DRILLED 8-1-02
5. TOTAL DEPTH: 340
6. DOES WELL REPLACE EXISTING WELL? YES ☐ NO ☑
7. STATIC WATER LEVEL Below Top of Casing: 80 FT.
(Use "+" if Above Top of Casing)
8. TOP OF CASING IS 2 FT. Above Land Surface*
*Top of casing terminated at/or below land surface requires a variance in accordance with 15A NCAC 2C .0118.
9. YIELD (gpm): 3 METHOD OF TEST Air
10. WATER ZONES (depth): 80-87-1 gal
132-137 2 gal
11. DISINFECTION: Type HTH Amount 30 Z
12. CASING:

	Depth		Diameter	Wall Thickness or Weight/Ft.	Material
From -1	To 52	Ft.	6 3/8	SDR21	PVC
From	To	Ft.			
From	To	Ft.			

13. GROUT:

	Depth		Material	Method
From 0	To 20	Ft.	Cement	poured
From	To	Ft.		

14. SCREEN:

	Depth		Diameter	Slot Size	Material
From	To	Ft.	in.	in.	
From	To	Ft.	in.	in.	

15. SAND/GRAVEL PACK:

	Depth		Size	Material
From	To	Ft.		
From	To	Ft.		

DEPTH From	To	DRILLING LOG Formation Description
0	46	brown dirt shale rock
46	80	granite
80	87	limestone, shale, rock
87	132	granite, limestone
132	137	brown slate
137	340	granite

LOCATION SKETCH
Show direction and distance in miles from at least two State Roads or County Roads. Include the road numbers and common road names.

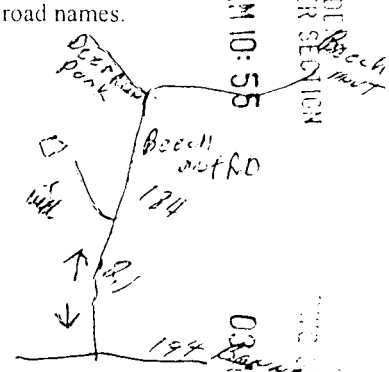

03 FEB 27 AM 10:55
RECEIVED / DENR
DWQ GROUNDWATER SECTION

03 MAR 14 PM 3:20
RECEIVED / DENR
DWQ GROUNDWATER SECTION

16. REMARKS: Moving to this Location when hse, finished

I DO HEREBY CERTIFY THAT THIS WELL WAS CONSTRUCTED IN ACCORDANCE WITH 15A NCAC 2C, WELL CONSTRUCTION STANDARDS, AND THAT A COPY OF THIS RECORD HAS BEEN PROVIDED TO THE WELL OWNER

Kenneth Jordan 8-1-02
SIGNATURE OF PERSON CONSTRUCTING THE WELL DATE

Submit the original to the Division of Water Quality, Groundwater Section, 1636 Mail Service Center - Raleigh, NC 27699-1636 Phone No. (919) 733-3221, within 30 days.

GW-1 REV. 07/2001