303060

WELL CONSTRUCTION RECORD

North Carolina - Department of Environment and Natural Resources - Division of Water Quality - Groundwater Section

WELL CONTRACTOR (INDIVIDUAL) NAME (print) Kevin Robarson CERTIFICATION # 2590

WELL CONTRACTOR COMPANY NAME Braswell Well Drilling PHONE # (828) 733-2692

STATE WELL CONSTRUCTION PERMIT# _____ (if applicable) ASSOCIATED WQ PERMIT# _____ (if applicable)

1. WELL USE (Check Applicable Box): Residential ☑ Municipal/Public ☐ Industrial ☐ Agricultural ☐ Monitoring ☐ Recovery ☐ Heat Pump Water Injection ☐ Other ☐ If Other, List Use _____

2. WELL LOCATION:
Nearest Town: Newland County Avery
200 Trice Fork mtn. Rd
(Street Name, Numbers, Community, Subdivision, Lot No., Zip Code)

Topographic/Land setting
☐Ridge ☑Slope ☐Valley ☐Flat
(check appropriate box)
Latitude/longitude of well location
_____
(degrees/minutes/seconds)
Latitude/longitude source: ☐GPS ☐Topographic map
(check box)

3.

DEPTH From	To	DRILLING LOG Formation Description
0	55	dirt/slate
55	180	slate

Area code - Phone number

4. DATE DRILLED 9-25-03
5. TOTAL DEPTH: 180 ft.
6. DOES WELL REPLACE EXISTING WELL? YES ☐ NO ☑
7. STATIC WATER LEVEL Below Top of Casing: 20 FT.
(Use "+" if Above Top of Casing)
8. TOP OF CASING IS 1 FT. Above Land Surface*
*Top of casing terminated at/or below land surface requires a variance in accordance with 15A NCAC 2C .0118.
9. YIELD (gpm): 4 METHOD OF TEST air
10. WATER ZONES (depth): 75, 110
11. DISINFECTION: Type Chlorine Amount 6oz
12. CASING:

	Depth		Diameter	Wall Thickness or Weight/Ft.	Material
From 0	To 63	Ft.	6 1/4	SDR 21	PVC
From	To	Ft.			
From	To	Ft.			

13. GROUT:

	Depth		Material	Method
From 0	To 25	Ft.	cement	poured
From	To	Ft.		

14. SCREEN:

	Depth		Diameter	Slot Size	Material
From	To	Ft.	in.	in.	
From	To	Ft.	in.	in.	

15. SAND/GRAVEL PACK:

	Depth		Size	Material
From	To	Ft.		
From	To	Ft.		

LOCATION SKETCH
Show direction and distance in miles from at least two State Roads or County Roads. Include the road numbers and common road names.

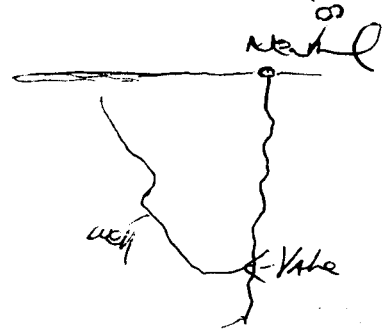

RECEIVED/DENR/DWQ AQUIFER PROTECTION SEC. 04 OCT -8 AM 10:26

16. REMARKS: _____

I DO HEREBY CERTIFY THAT THIS WELL WAS CONSTRUCTED IN ACCORDANCE WITH 15A NCAC 2C, WELL CONSTRUCTION STANDARDS, AND THAT A COPY OF THIS RECORD HAS BEEN PROVIDED TO THE WELL OWNER

Kevin Robarson 9-25-03
SIGNATURE OF PERSON CONSTRUCTING THE WELL DATE

Submit the original to the Division of Water Quality, Groundwater Section, 1636 Mail Service Center - Raleigh, NC 27699-1636 Phone No. (919) 733-3221, within 30 days.

GW-1 REV. 07/2001