ard 305995

North Carolina - Department of Environment and Natural Resources - Division of Water Quality - Groundwater Section
1636 Mail Service Center - Raleigh, N.C. 27699-1636 - Phone (919) 733-3221

WELL CONSTRUCTION RECORD

040565

WELL CONTRACTOR: Dewey Wright Well Pump Co., Inc.
WELL CONTRACTOR CERTIFICATION #: 2681
STATE WELL CONSTRUCTION PERMIT#: Steve Petty

1. **WELL USE (Check Applicable Box):** Residential [X] Municipal [ ] Industrial [ ] Agricultural [ ] Monitoring [ ] Recovery [ ] Heat Pump Water Injection [ ] Other [ ] If Other, List Use:

2. WELL LOCATION: (Show sketch of the location below)
Nearest Town: NEWLAND County: AVERY
MISTY MTN LN. OFF STAPLES JOHNSON RD. OFF SQUI
(Road Name and Numbers, Community, or Subdivision and Lot No.)

3. DRILLING LOG

From	To	DEPTH Formation Description
0	90	DIRT
90	382	GRANITE
382	405	GRANITE

If additional space is needed use back of form

4. DATE DRILLED 11/11/2004
5. TOTAL DEPTH 405
6. CUTTINGS COLLECTED YES [ ] NO [X]
7. DOES WELL REPLACE EXISTING WELL? YES [ ] NO [X]
8. STATIC WATER LEVEL Below Top of Casing: 100 FT. (Use "+" if Above Top of Casing)
9. TOP OF CASING IS 1 FT. Above Land Surface*
*Top of casing terminated at/or below land surface requires a variance in accordance with 15A NCAC 2C.0118
10. YIELD (gpm): 4 METHOD OF TEST Air
11. WATER ZONES (depth): 4.00 gpm 382-383 0.00 gpm
0.00 gpm 0.00 gpm
12. CHLORINATION: Type HTH Amount 64

05 JAN -3 PM 4:17

13. CASING:

	Depth From	To	Ft.	Diameter	Wall Thickness or Weight/Ft.	Material
	0	97		6 1/8	.350	PVC

14. GROUT:

	Depth From	To	Ft.	Material	Method
	0	20		Cement	Gravity Flow

15. SCREEN:

	Depth From	To	Ft.	Diameter	Slot Size	Material
				in.	in.	
				in.	in.	
				in.	in.	

16. SAND/GRAVEL PACK:

	Depth From	To	Ft.	Size	Material

LOCATION SKETCH
(Show direction and distance from at least two State Roads, or other map reference points)

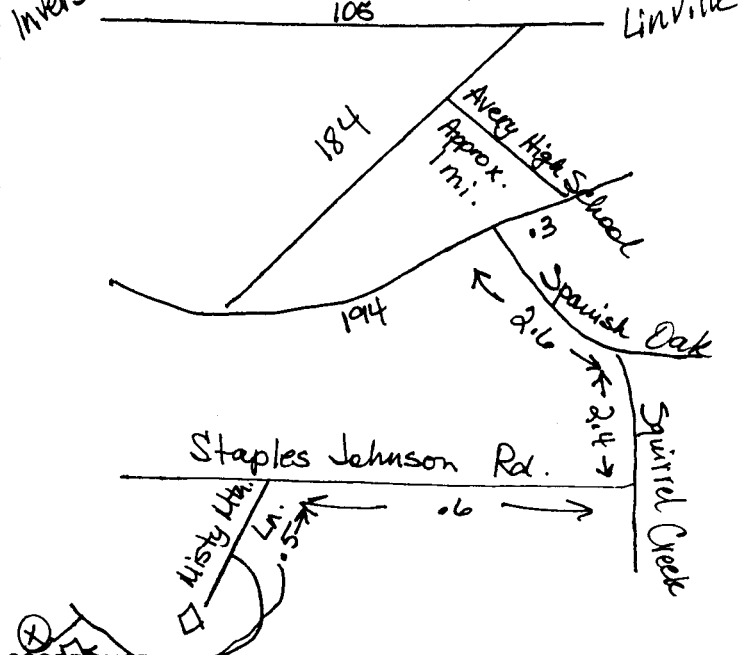

17. REMARKS:
I DO HEREBY CERTIFY THAT THIS WELL WAS CONSTRUCTED IN ACCORDANCE WITH 15A NCAC 2C, WELL CONSTRUCTION STANDARDS, AND THAT A COPY OF THIS RECORD HAS BEEN PROVIDED TO THE WELL OWNER.

Steve Petty 12-10-04
SIGNATURE OF PERSON CONSTRUCTING THE WELL DATE
Submit original to Division of Water Quality, Groundwater Section within 30 days

FOR OFFICE USE ONLY
Quad No:
Serial No.

GW-1 REV. 12/99