# WELL CONSTRUCTION RECORD

AKO

313693

North Carolina - Department of Environment and Natural Resources - Division of Water Quality - Groundwater Section

WELL CONTRACTOR (INDIVIDUAL) NAME (print) Kevin Roberson CERTIFICATION # 2590

WELL CONTRACTOR COMPANY NAME Mitchell Well Drilling PHONE # 828 765-2441

STATE WELL CONSTRUCTION PERMIT# _____ (if applicable) ASSOCIATED WQ PERMIT# _____ (if applicable)

1. WELL USE (Check Applicable Box): Residential ☑ Municipal/Public ☐ Industrial ☐ Agricultural ☐ Monitoring ☐ Recovery ☐ Heat Pump Water Injection ☐ Other ☐ If Other, List Use _____

2. WELL LOCATION:
Nearest Town: Newland County Avery
N/A Mullens Hill Rd - 3-mile
(Street Name, Numbers, Community, Subdivision, Lot No., Zip Code)

Topographic/Land setting
☑ Ridge ☐ Slope ☐ Valley ☐ Flat
(check appropriate box)
Latitude/longitude of well location
_____
(degrees/minutes/seconds)
Latitude/longitude source: ☐ GPS ☐ Topographic map
(check box)

3. _____
Area code- Phone number

4. DATE DRILLED 6-6-05
5. TOTAL DEPTH: 360 ft.
6. DOES WELL REPLACE EXISTING WELL? YES ☐ NO ☑
7. STATIC WATER LEVEL Below Top of Casing: _____ FT.
(Use "+" if Above Top of Casing)
8. TOP OF CASING IS 1 FT. Above Land Surface*
*Top of casing terminated at/or below land surface requires a variance in accordance with 15A NCAC 2C .0118.
9. YIELD (gpm): 2 METHOD OF TEST AR
10. WATER ZONES (depth): 100, 200, 280, 340
11. DISINFECTION: Type chlorine Amount 6 oz.
12. CASING:

| | Depth From | Depth To | Diameter | Wall Thickness or Weight/Ft. | Material |
|---|---|---|---|---|---|
| | 0 | 71 | 6 1/4 | SDR 21 | PVC |
| | | | | | |
| | | | | | |

13. GROUT:

| | Depth From | Depth To | Material | Method |
|---|---|---|---|---|
| | 0 | 20 | cement | poured |
| | | | | |

14. SCREEN:

| | Depth From | Depth To | Diameter | Slot Size | Material |
|---|---|---|---|---|---|
| | | | in. | in. | |
| | | | in. | in. | |

15. SAND/GRAVEL PACK:

| | Depth From | Depth To | Size | Material |
|---|---|---|---|---|
| | | | | |
| | | | | |

LOCATION SKETCH
Show direction and distance in miles from at least two State Roads or County Roads. Include the road numbers and common road names.

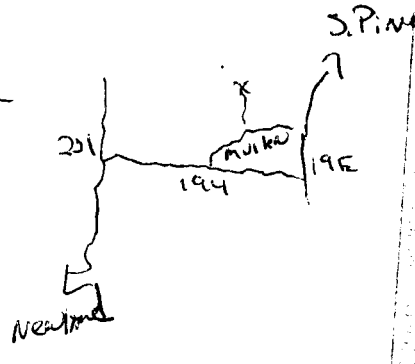


16. REMARKS: _____

I DO HEREBY CERTIFY THAT THIS WELL WAS CONSTRUCTED IN ACCORDANCE WITH 15A NCAC 2C, WELL CONSTRUCTION STANDARDS, AND THAT A COPY OF THIS RECORD HAS BEEN PROVIDED TO THE WELL OWNER

Kevin Roberson 6-6-05
SIGNATURE OF PERSON CONSTRUCTING THE WELL DATE

**Submit the original to the Division of Water Quality, Groundwater Section, 1636 Mail Service Center - Raleigh, NC 27699-1636 Phone No. (919) 733-3221, within 30 days.**

GW-1 REV. 07/2001

RECEIVED BY CENTRAL FILES JUL 15 2005