North Carolina - Department of Environment and Natural Resources - Division of Water Quality - Groundwater Section
1636 Mail Service Center - Raleigh, N.C. 27699-1636 - Phone (919) 733-3221

ARO 316246

WELL CONSTRUCTION RECORD

050489

WELL CONTRACTOR: Dewey Wright Well Pump Co. Inc.
WELL CONTRACTOR CERTIFICATION #: 2887
STATE WELL CONSTRUCTION PERMIT#: Steve Reece

1. **WELL USE (Check Applicable Box):** Residential [X] Municipal [ ] Industrial [ ] Agricultural [ ] Monitoring [ ]
Recovery [ ] Heat Pump Water Injection [ ] Other [ ] If Other, List Use: _____

2. WELL LOCATION: (Show sketch of the location below)
Nearest Town: INVERSHIELD County: AVERY
LOT C-19 OFF EAGLES NEST OFF 184 OFF 184 OFF 105
(Road Name and Numbers, Community, or Subdivision and Lot No.)

3. DRILLING LOG

From	To	Formation Description
0	70	DIRT
70	130	GRANITE BROWN ROCK
130	133	SHALE
133	430	GRANITE
430	433	SHALE
433	500	GRANITE

If additional space is needed use back of form

4. DATE DRILLED 8/17/2005
5. TOTAL DEPTH 500
6. CUTTINGS COLLECTED YES [ ] NO [X]
7. DOES WELL REPLACE EXISTING WELL? YES [ ] NO [X]
8. STATIC WATER LEVEL Below Top of Casing: 30 FT.
(Use "+" if Above Top of Casing)
9. TOP OF CASING IS 1 FT. Above Land Surface*
*Top of casing terminated at/or below land surface requires a variance in accordance with 15A NCAC 2C.0118
10. YIELD (gpm): 50 METHOD OF TEST Air
11. WATER ZONES (depth): 4.00 gpm 70-130 48.00 gpm 133-430
0.00 gpm 0.00 gpm
12. CHLORINATION: Type HTH Amount 90

13. CASING:

	Depth From	Depth To	Diameter	Wall Thickness or Weight/Ft.	Material
From	0	77 Ft.	8 1/8	350	PVC
From		Ft.			
From		Ft.			

14. GROUT:

	Depth From	Depth To	Material	Method
From	0	20 Ft.	Cement	Gravity Flow
From		Ft.		

15. SCREEN:

	Depth From	Depth To	Diameter	Slot Size	Material
From		Ft.	in.	in.	
From		Ft.	in.	in.	
From		Ft.	in.	in.	

16. SAND/GRAVEL PACK:

	Depth From	Depth To	Size	Material
From		Ft.		
From		Ft.		

LOCATION SKETCH
(Show direction and distance from at least two State Roads, or other map reference points)

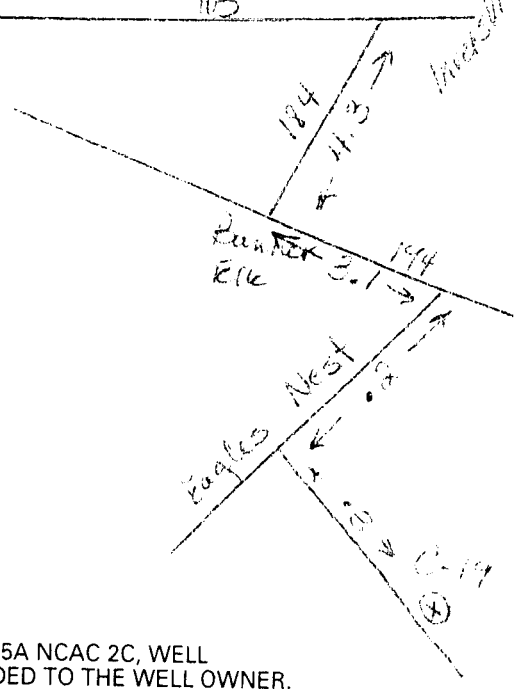

17. REMARKS: _____

I DO HEREBY CERTIFY THAT THIS WELL WAS CONSTRUCTED IN ACCORDANCE WITH 15A NCAC 2C, WELL CONSTRUCTION STANDARDS, AND THAT A COPY OF THIS RECORD HAS BEEN PROVIDED TO THE WELL OWNER.

Steve Reece 9-12-05
SIGNATURE OF PERSON CONSTRUCTING THE WELL DATE
Submit original to Division of Water Quality, Groundwater Section within 30 days

FOR OFFICE USE ONLY
Quad No: _____
Serial No. _____

GW-1 REV. 12/99