33423
5

North Carolina - Department of Environment and Natural Resources - Division of Water Quality - Groundwater Section
1636 Mail Service Center - Raleigh, N.C. 27699-1636-Phone (919) 733-3221

WELL CONSTRUCTION RECORD

WELL CONTRACTOR: Clearwater
WELL CONTRACTOR CERTIFICATION #: 2113
STATE WELL CONSTRUCTION PERMIT#:

1. WELL USE (Check Applicable Box): Residential ☑ Municipal ☐ Industrial ☐ Agricultural ☐ Monitoring ☐
Recovery ☐ Heat Pump Water Injection ☐ Other ☐ If Other, List Use:

2. WELL LOCATION: (Show sketch of the location below)
Nearest Town: Spruce Pine County: Avery
(Road Name and Number, C...

3.

DRILLING LOG From	To	DEPTH Formation Description
1	94	sand + dirt
94	579	granite
579	580	crevice
580	700	granite

State Zip Code

4. DATE DRILLED 9-14-06
5. TOTAL DEPTH 700
6. CUTTINGS COLLECTED YES ☐ NO ☑
7. DOES WELL REPLACE EXISTING WELL? YES ☐ NO ☑
8. STATIC WATER LEVEL Below Top of Casing: ____ FT.
9. TOP OF CASING IS 1 FT. Above Land Surface* (Use "+" If Above Top of Casing)
*Top of casing terminated at/or below land surface requires a variance in accordance with 15A NCAC 2C .0118
10. YIELD (gpm): 1 METHOD OF TEST Pig
11. WATER ZONES (depth):
12. CHLORINATION: Type ____ Amount ____
13. CASING:

If additional space is needed use back of form

RECEIVED DIV OF WATER QUALITY SEP 2 2006

	Depth From	To	Diameter	Wall Thickness or Weight/Ft.	Material
	1	94	6 1/4		plastic

14. GROUT:

	Depth From	To	Material	Method
	1	20	cement	

15. SCREEN:

	Depth From	To	Diameter	Slot Size	Material

16. SAND/GRAVEL PACK:

	Depth From	To	Size	Material

17. REMARKS:

LOCATION SKETCH
(Show direction and distance from at least two State Roads, or other map reference points)

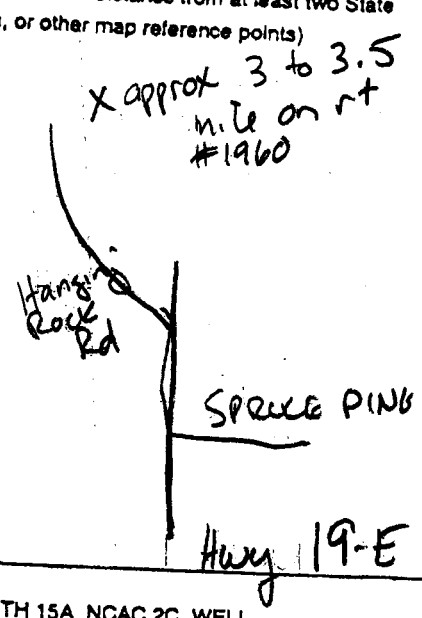

I DO HEREBY CERTIFY THAT THIS WELL WAS CONSTRUCTED IN ACCORDANCE WITH 15A NCAC 2C, WELL CONSTRUCTION STANDARDS, AND THAT A COPY OF THIS RECORD HAS BEEN PROVIDED TO THE WELL OWNER.

Ry Merlow 9-15-06
SIGNATURE OF PERSON CONSTRUCTING THE WELL DATE

Submit original to Division of Water Quality, Groundwater Section within 30 days

FOR OFFICE USE ONLY
Quad No:
Serial No.