North Carolina - Department of Environment and Natural Resources - Division of Water Quality - Groundwater Section
1636 Mail Service Center - Raleigh, N.C. 27699-1636 - Phone (919) 733-3221

239379

WELL CONSTRUCTION RECORD

010661

WELL CONTRACTOR: Dewey Wright Well Pump Co., Inc.
WELL CONTRACTOR CERTIFICATION #: 2686
STATE WELL CONSTRUCTION PERMIT#: Leslie Reece

1. **WELL USE (Check Applicable Box):** Residential [X] Municipal [ ] Industrial [ ] Agricultural [ ] Monitoring [ ] Recovery [ ] Heat Pump Water Injection [ ] Other [ ] If Other, List Use:

2. WELL LOCATION: (Show sketch of the location below)
Nearest Town: BANNER ELK County: AVERY
JOE CLARK RD. OFF BANNER CREEK RD OFF HWY 184
(Road Name and Numbers, Community, or Subdivision and Lot No.)

3. DRILLING LOG / DEPTH

From	To	Formation Description
0	70	DIRT
70	273	GRANITE
273	274	SHALE
274	285	GRANITE

If additional space is needed use back of form

4. DATE DRILLED 8/20/2001
5. TOTAL DEPTH 285
6. CUTTINGS COLLECTED YES [ ] NO [X]
7. DOES WELL REPLACE EXISTING WELL? YES [ ] NO [X]
8. STATIC WATER LEVEL Below Top of Casing: 30 FT.
(Use "+" if Above Top of Casing)
9. TOP OF CASING IS 1 FT. Above Land Surface*
*Top of casing terminated at/or below land surface requires a variance in accordance with 15A NCAC 2C.0118
10. YIELD (gpm): 75 METHOD OF TEST Air
11. WATER ZONES (depth): 75 gpm 273-274 0 gpm
0 gpm 0 gpm
12. CHLORINATION: Type HTH Amount 53

RECEIVED / DENR
GROUNDWATER SECTION
01 SEP 24 AM 10: 20
DWQ

13. CASING:

	Depth	Diameter	Wall Thickness or Weight/Ft.	Material
From 0	To 70 Ft.	6 1/8	.350	PVC
From	To Ft.			
From	To Ft.			

14. GROUT:

	Depth	Material	Method
From 0	To 20 Ft.	Cement	Gravity Flow
From	To Ft.	CEMENT	GRAVITY FLOW

15. SCREEN:

	Depth	Diameter	Slot Size	Material
From	To Ft.	in.	in.	
From	To Ft.	in.	in.	
From	To Ft.	in.	in.	

16. SAND/GRAVEL PACK:

	Depth	Size	Material
From	To Ft.		
From	To Ft.		

LOCATION SKETCH
(Show direction and distance from at least two State Roads, or other map reference points)

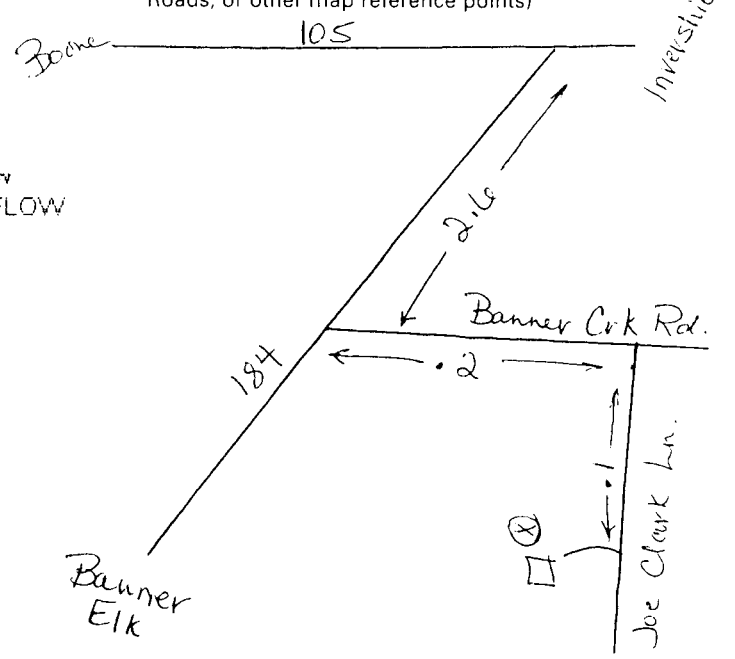

17. REMARKS:
I DO HEREBY CERTIFY THAT THIS WELL WAS CONSTRUCTED IN ACCORDANCE WITH 15A NCAC 2C, WELL CONSTRUCTION STANDARDS, AND THAT A COPY OF THIS RECORD HAS BEEN PROVIDED TO THE WELL OWNER.

Leslie Wayne Reece 9-19-01
SIGNATURE OF PERSON CONSTRUCTING THE WELL DATE
Submit original to Division of Water Quality, Groundwater Section within 30 days

GW-1 REV. 12/99

FOR OFFICE USE ONLY
Quad No:
Serial No.